


# T. 36 S., R. 6 W., W.M.

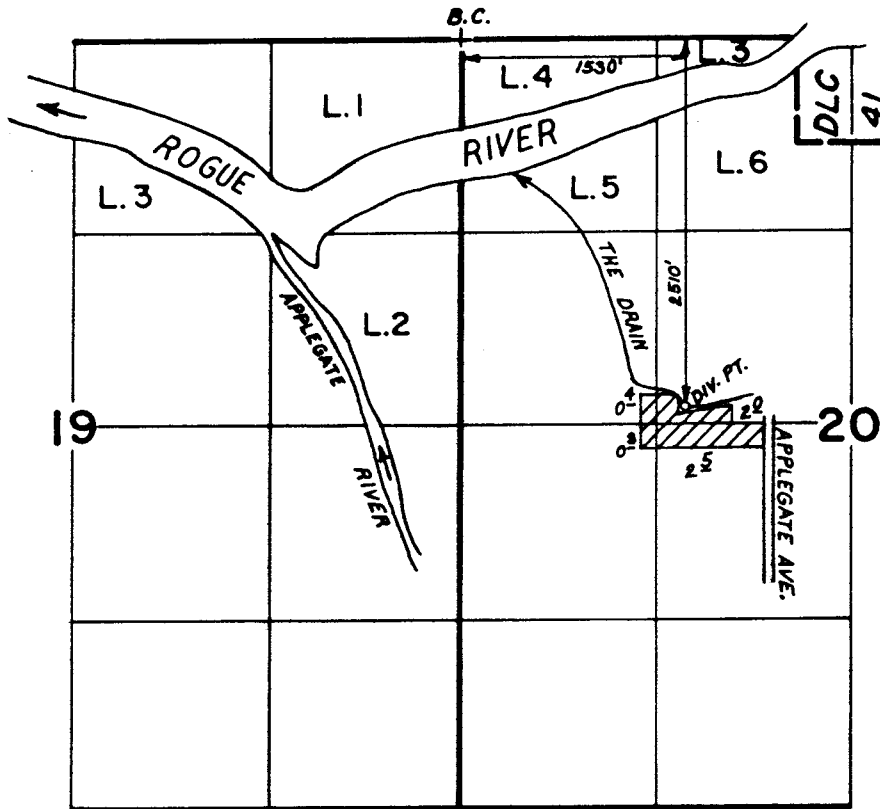

SCALE: 1"=1320'

## FINAL PROOF SURVEY UNDER

Application No. 57372 Permit No. 43465  
IN NAME OF

APPLEGATE BAR RANCH c/o BOB & DEANNA COPELAND

Surveyed JAN. 18 1984, by B.S. JAMES