


T. 38 S., R. 5 W., W. M.

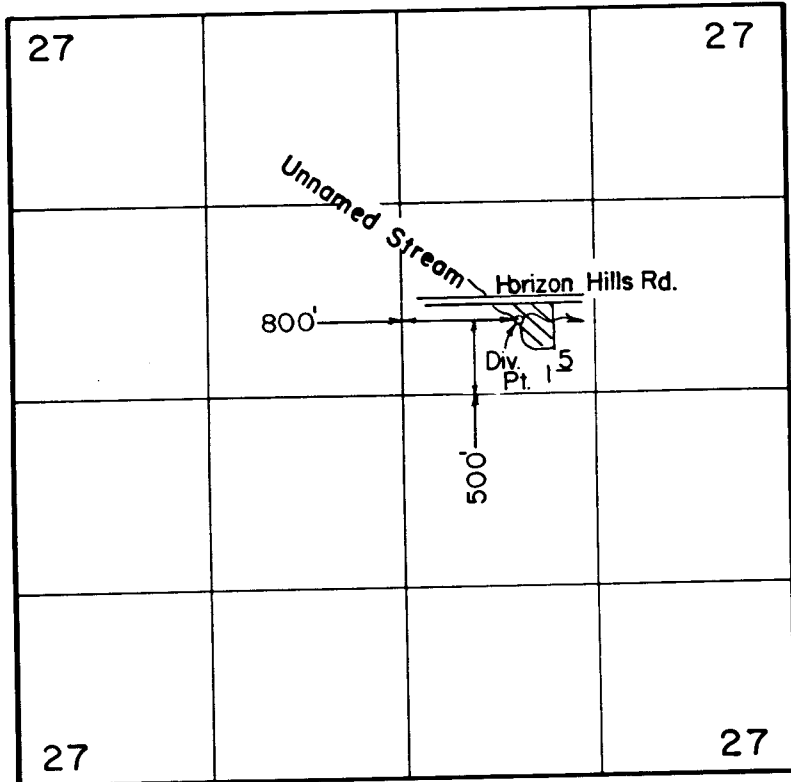

Scale: 1" = 1320'

RECEIVED

APR 24 1991

WM. DIST. 14
GRANTS PASS, ORE.

**FINAL PROOF SURVEY
UNDER**

Application No. 57681... Permit No. 43467...
IN NAME OF

GEORGE R. & BERNICE ZETTLMAIER

Surveyed AUG. 9. 1988., by B. S. JAMES...

71430-129-1284

LMJ
5/89