



T. 33 S., R. 6 W., W.M.

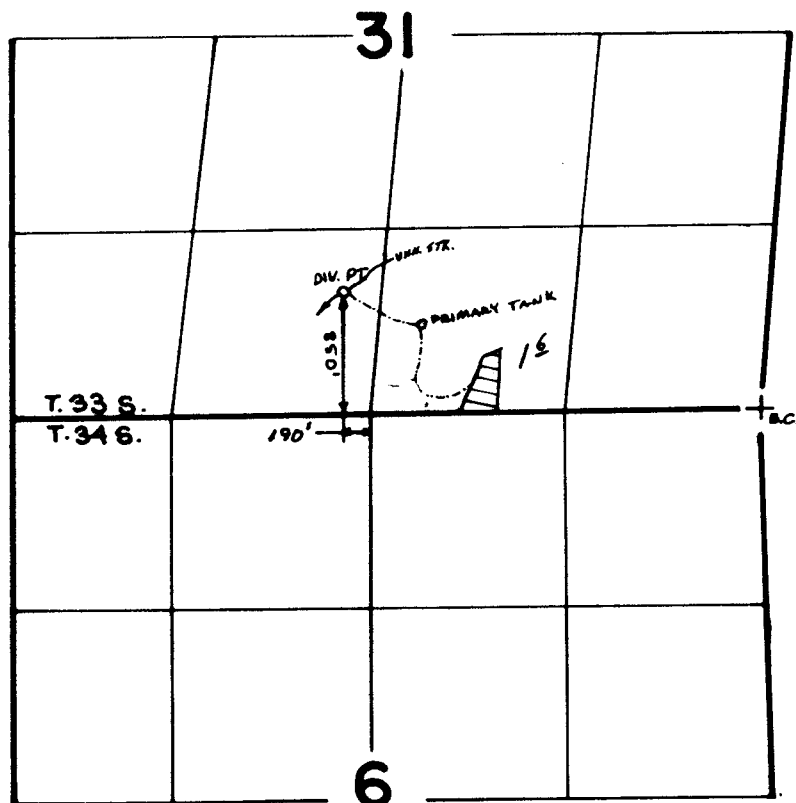

Scale 4" = 1 Mile

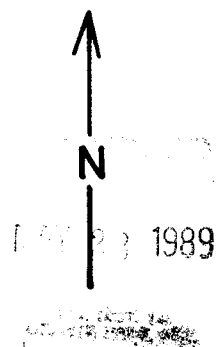

FINAL PROOF SURVEY
UNDER

Application No. 57717 Permit No. 43471
IN NAME OF

.....HERBERT.....B.....DUNHAM.....

Surveyed Aug...23, 19.84, by J.R. WOODROOF

41033-179-154L

Jaw