


T.36S., R.5W., W.M.

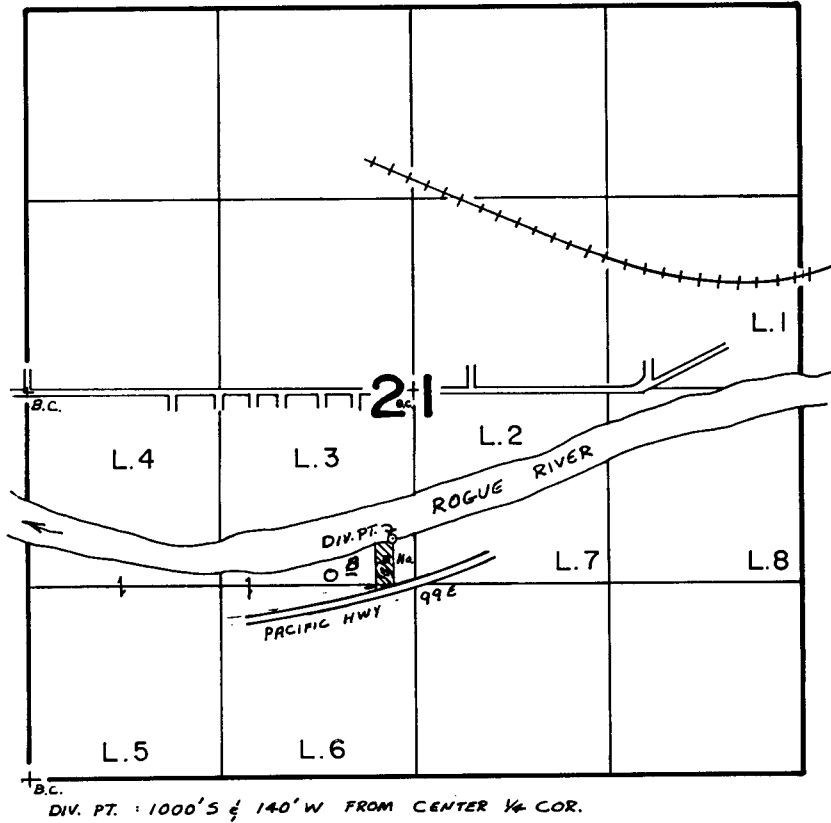

Scale 4" = 1 mile

FINAL PROOF SURVEY
UNDER

Application No. 57.786. Permit No. 434.75.....
IN NAME OF

.....RUBY V. SMITH.....

Surveyed Nov...4... 19.81., by Bruce...R...Sund

RECEIVED

APR 1 1987

WY. DIST. 14
SCANDS PAGE, OREG.