

Application No. 57507  
Permit No. 43477

RECEIVED

JUL 22 1978

WATER RESOURCES DEPT.  
SALEM, OREGON



T305

R 2 W W M

RECEIVED

SEP 1 1978

WATER RESOURCES DEPT.  
SALEM, OREGON

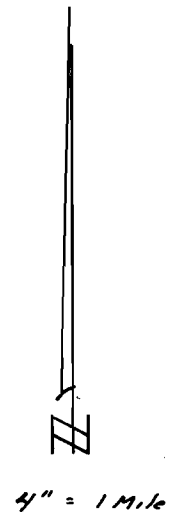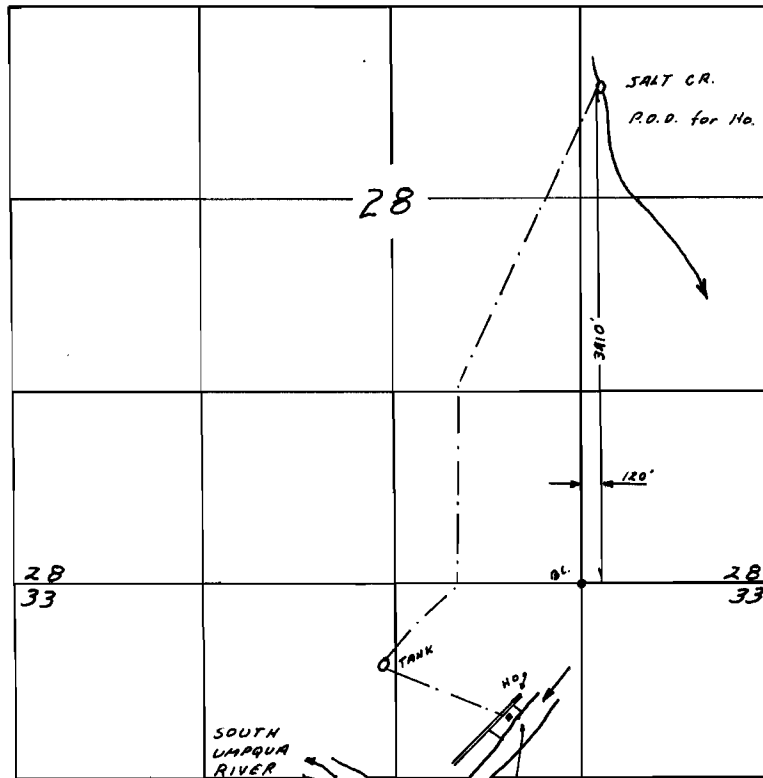

R.O.D. for 1/2 acre Lawn + Garden  
910'S, 450'W from NE cor.  
NW 1/4 NE 1/4 Sec. 33

Assisted by. *[Signature]*