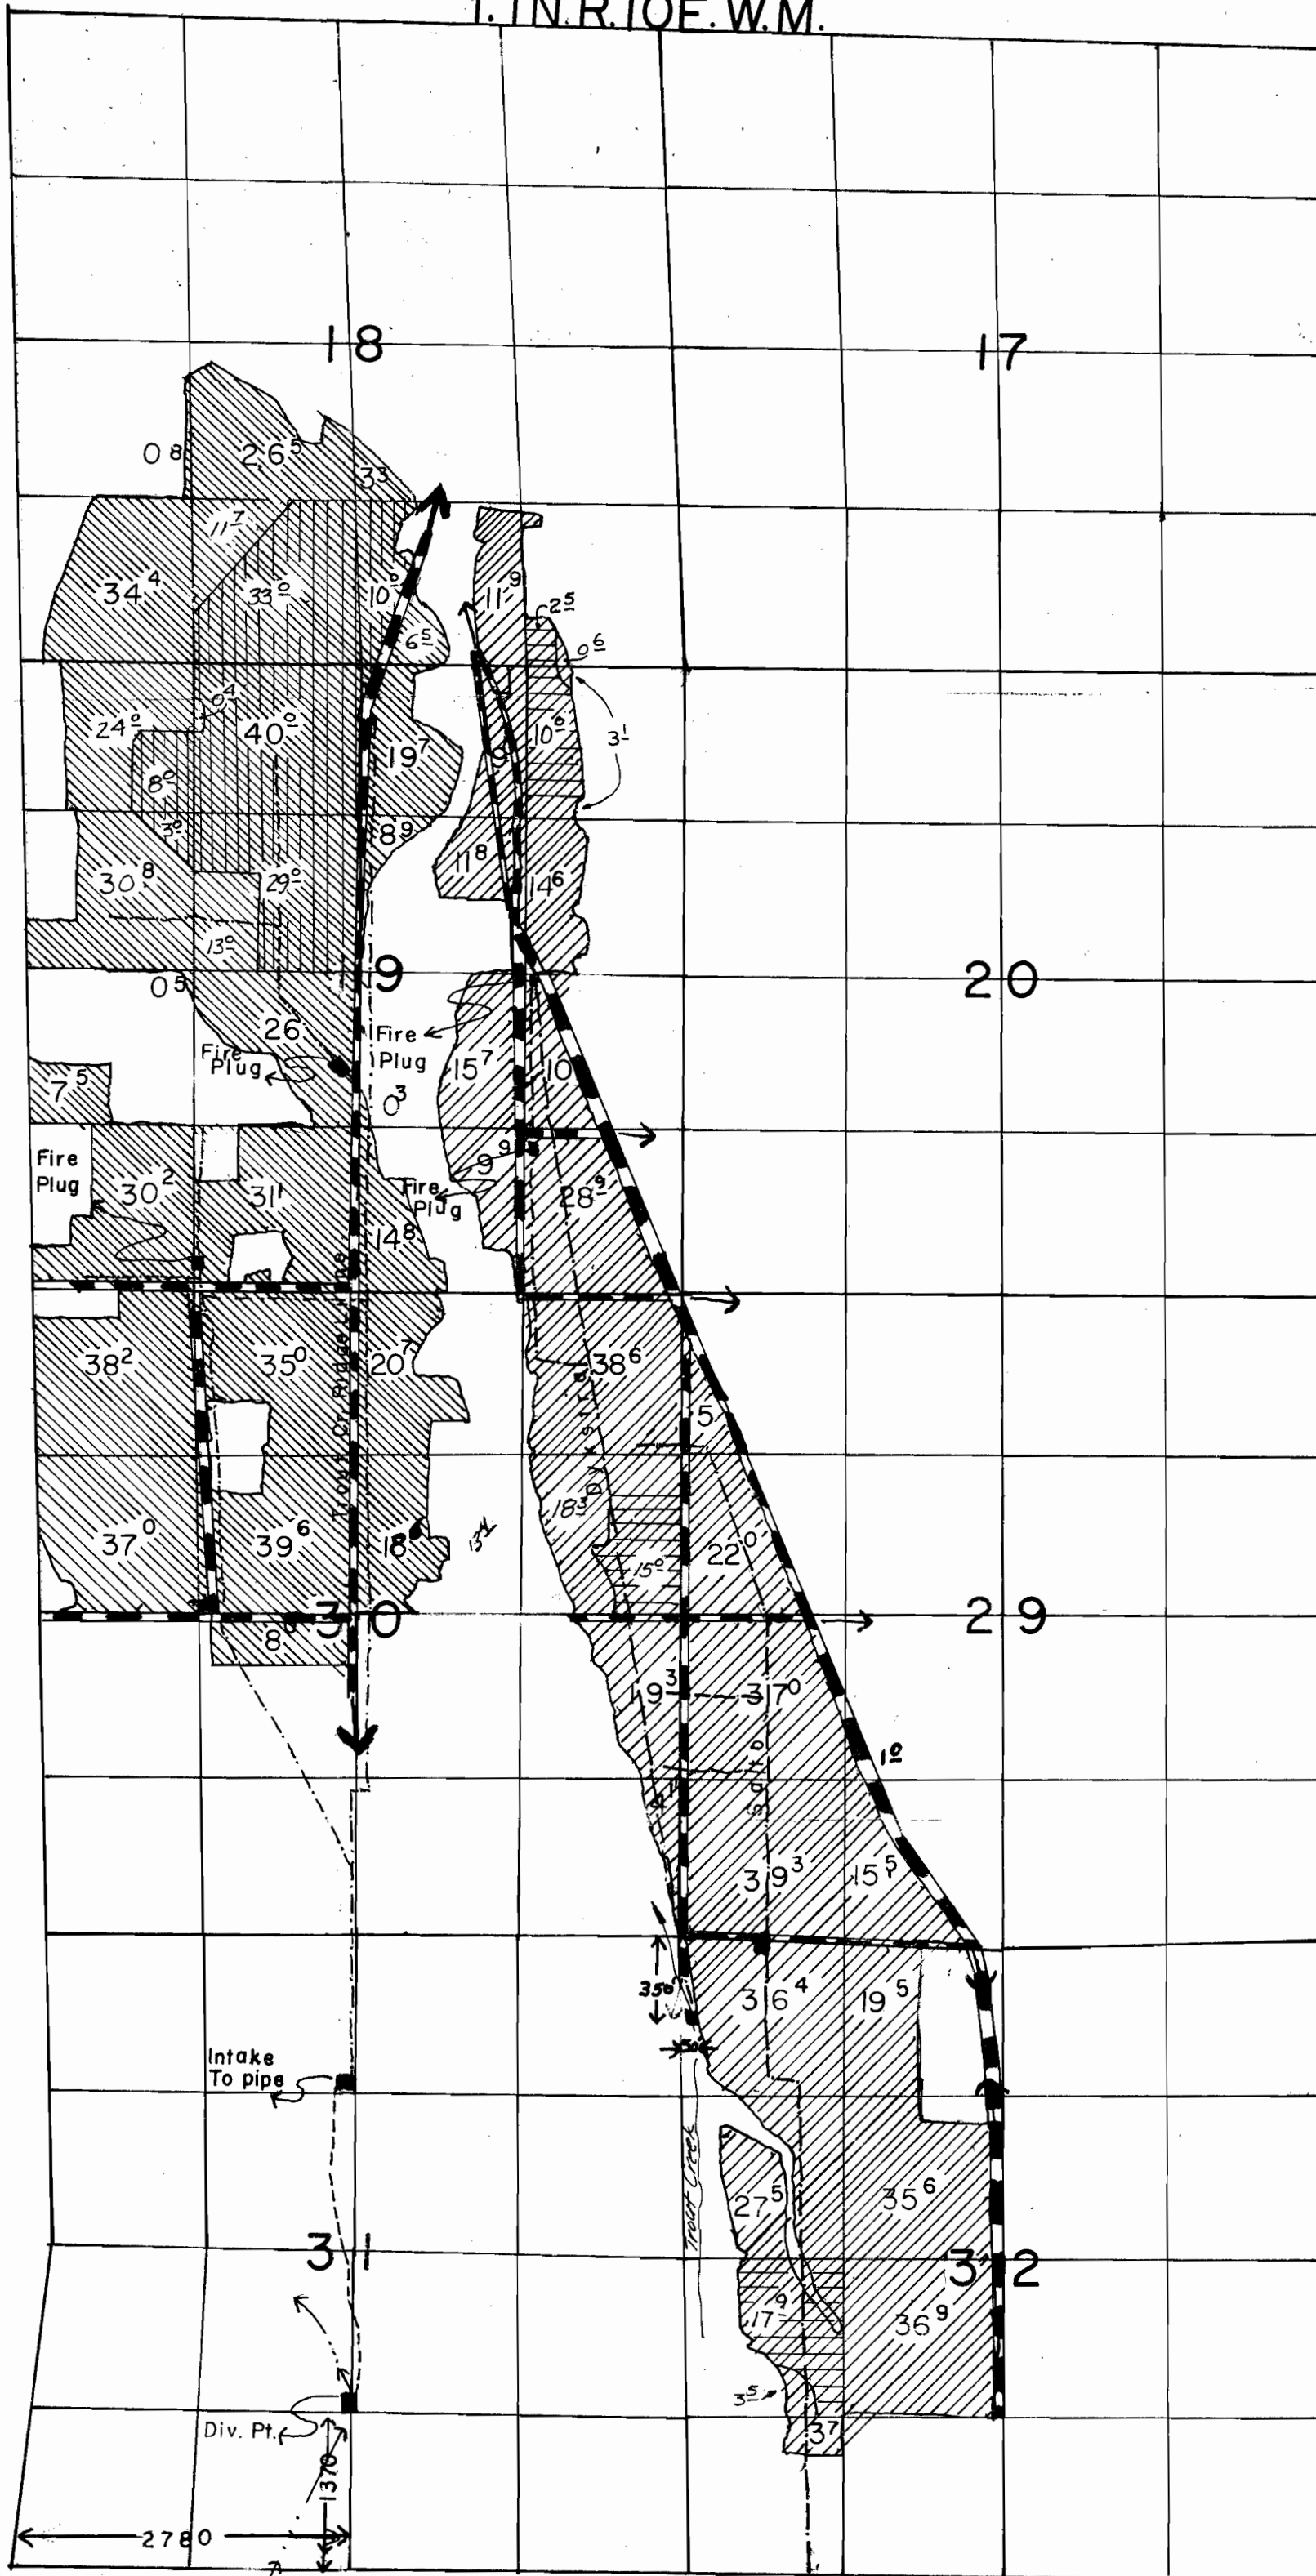

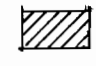


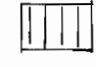

Roger & Trout Cr. Ridge Lines

T. 1 N. R. 10 E. W. M.

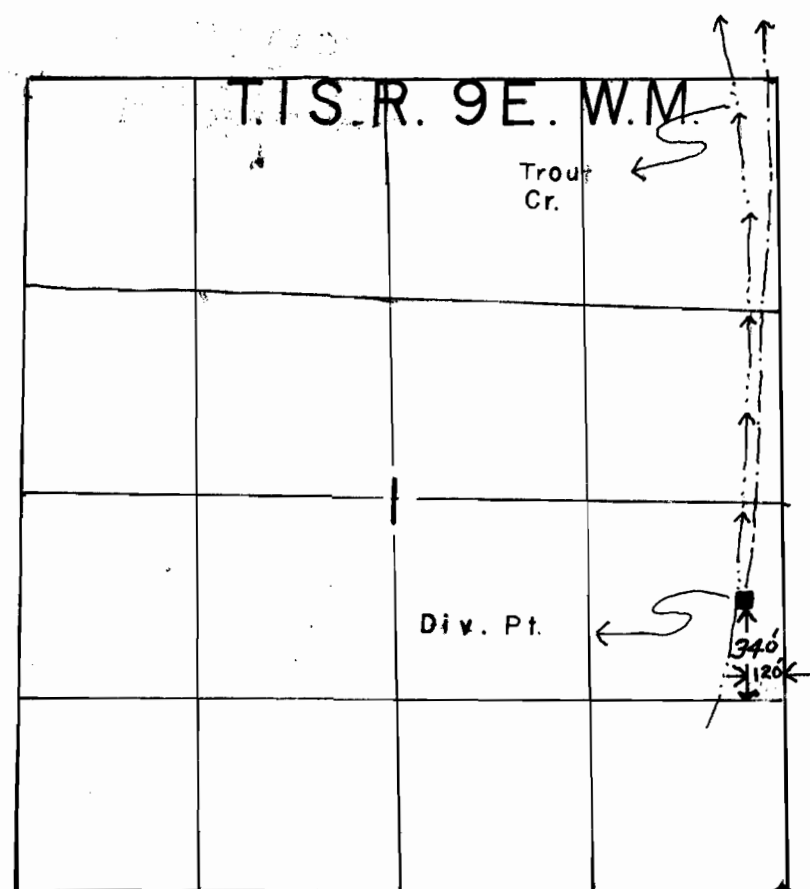


 Roger Cr. Water
 Trout Cr. Water
 Scale 4" = 1 Mile

Eliot Cr. Div. Loc: - 2400' S. & 125' E
 from N/4 Cor. Sec 26, T. 1 S. R. 9 E.
 Clear Cr. Div. Loc: - 520' S. & 2500' W
 from NE Cor. Sec. 27, T. 1 S. R. 9 E.
 (both survey 6/19/75 by T. Paul
 App 45717)

 Existing Irrigation right from Roger Cr.
 Existing Irrigation right from Trout Cr.

Application No. 49108 49109
 Permit No. 43519 43520



Roger Cr.