


T.33S., R.7W., W.M.

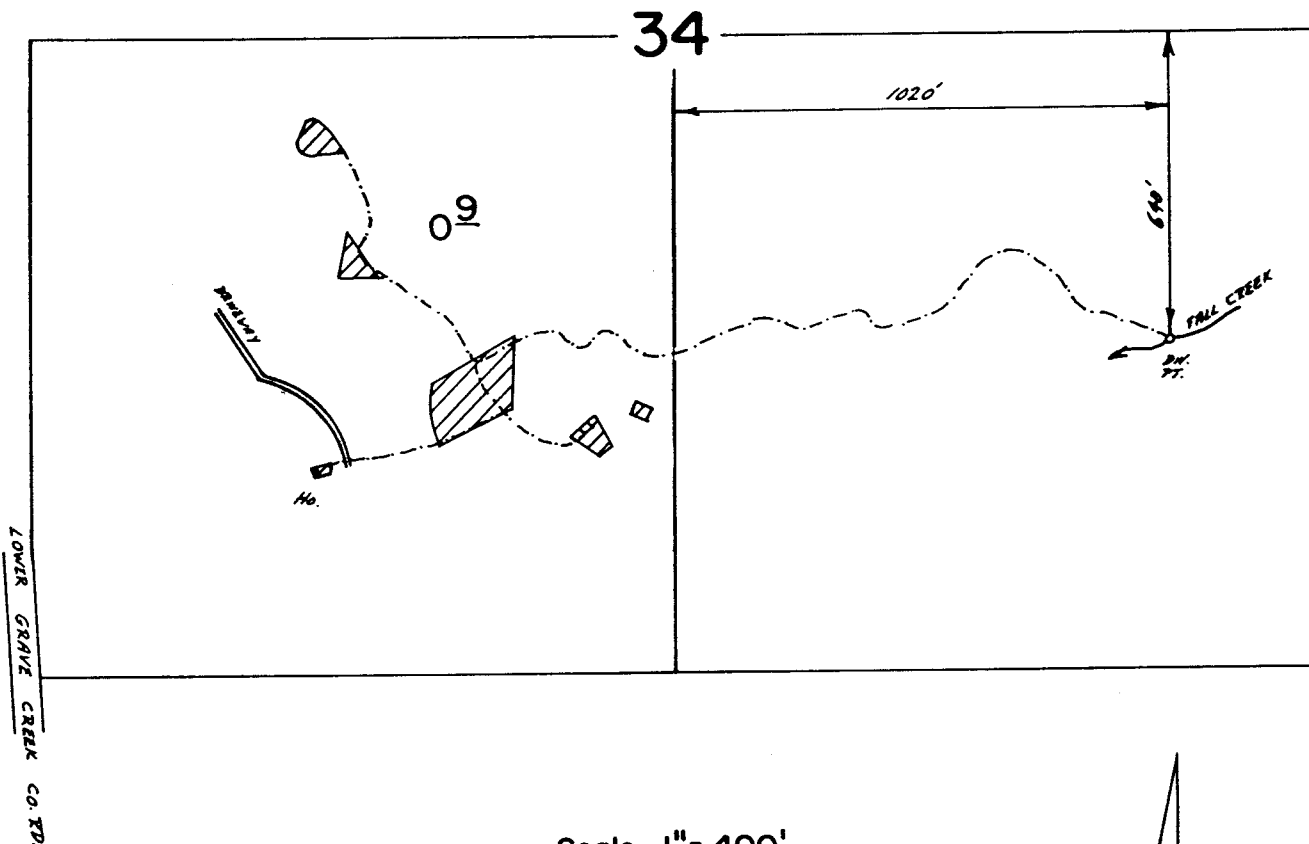

Scale 1" = 400'

**FINAL PROOF SURVEY**  
UNDER

Application No. 57323 Permit No. 43538  
IN NAME OF

.....BOB.....JIRUCHA.....

Surveyed Sept. 27, 1984, by J.R. WOODROOF

RECEIVED  
MAR 26 1989