
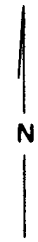


T. 38 S., R. 8 W., W.M.

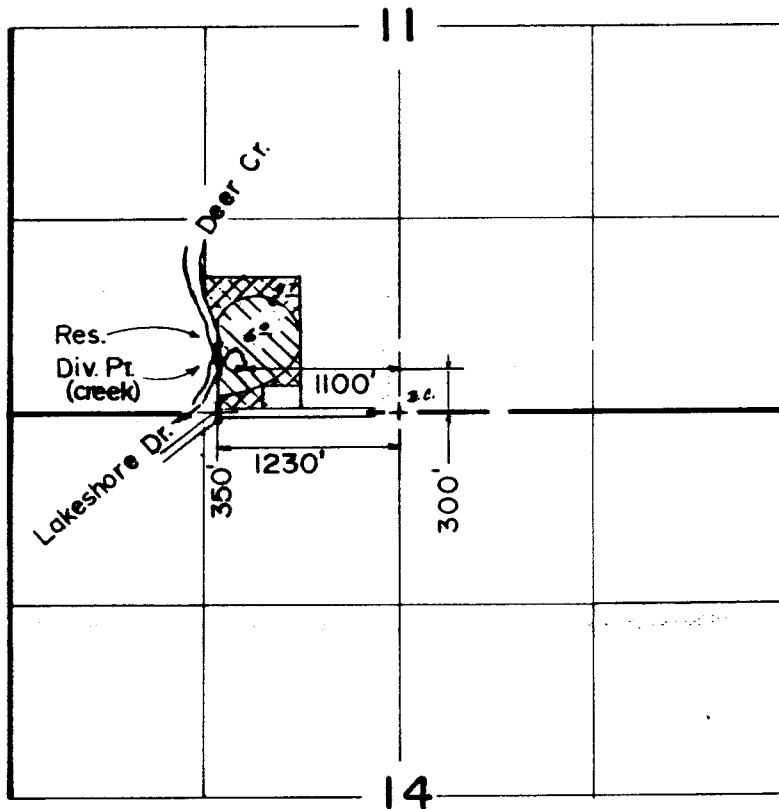

RECEIVED

SEP 11 1989

USE DATE IN
COURT CASES, ETC.

Scale: 1" = 1320'

Primary



Supplemental



FINAL PROOF SURVEY
UNDER

R-57539

R-7706

Application No. ~~57540~~ Permit No. ~~43539~~

IN NAME OF

.....AARON J. SCHEER.....

Surveyed JUN. 9, 1986, by B. S. JAMES.