


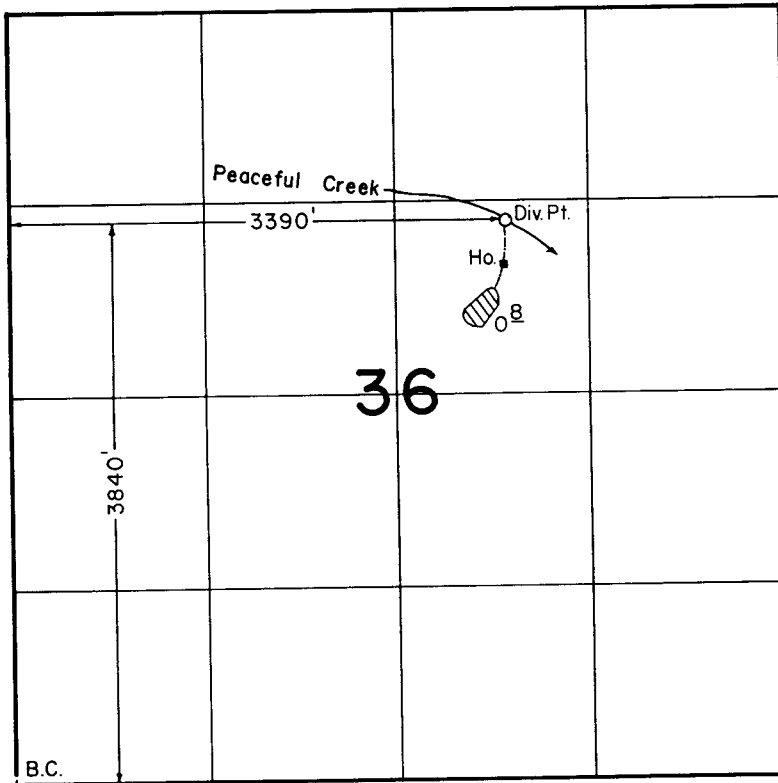

T. 34 S., R. 5 W., W.M.



SCALE: 1" = 1320'

RECEIVED

MAR 27 1991

WM. DIST. 14
GRANTS PASS, ORE.

FINAL PROOF SURVEY
UNDER

Application No. 57742. Permit No. 43593.....
IN NAME OF

.....**PHILIP KING**.....

Surveyed **JUNE 13, 1989**, by **B. S. JAMES**.....

12-18-89
41033-179-118 R