


RECEIVED  
SEP 27 1978  
WATER RESOURCES DEPT.  
SALEM, OREGON

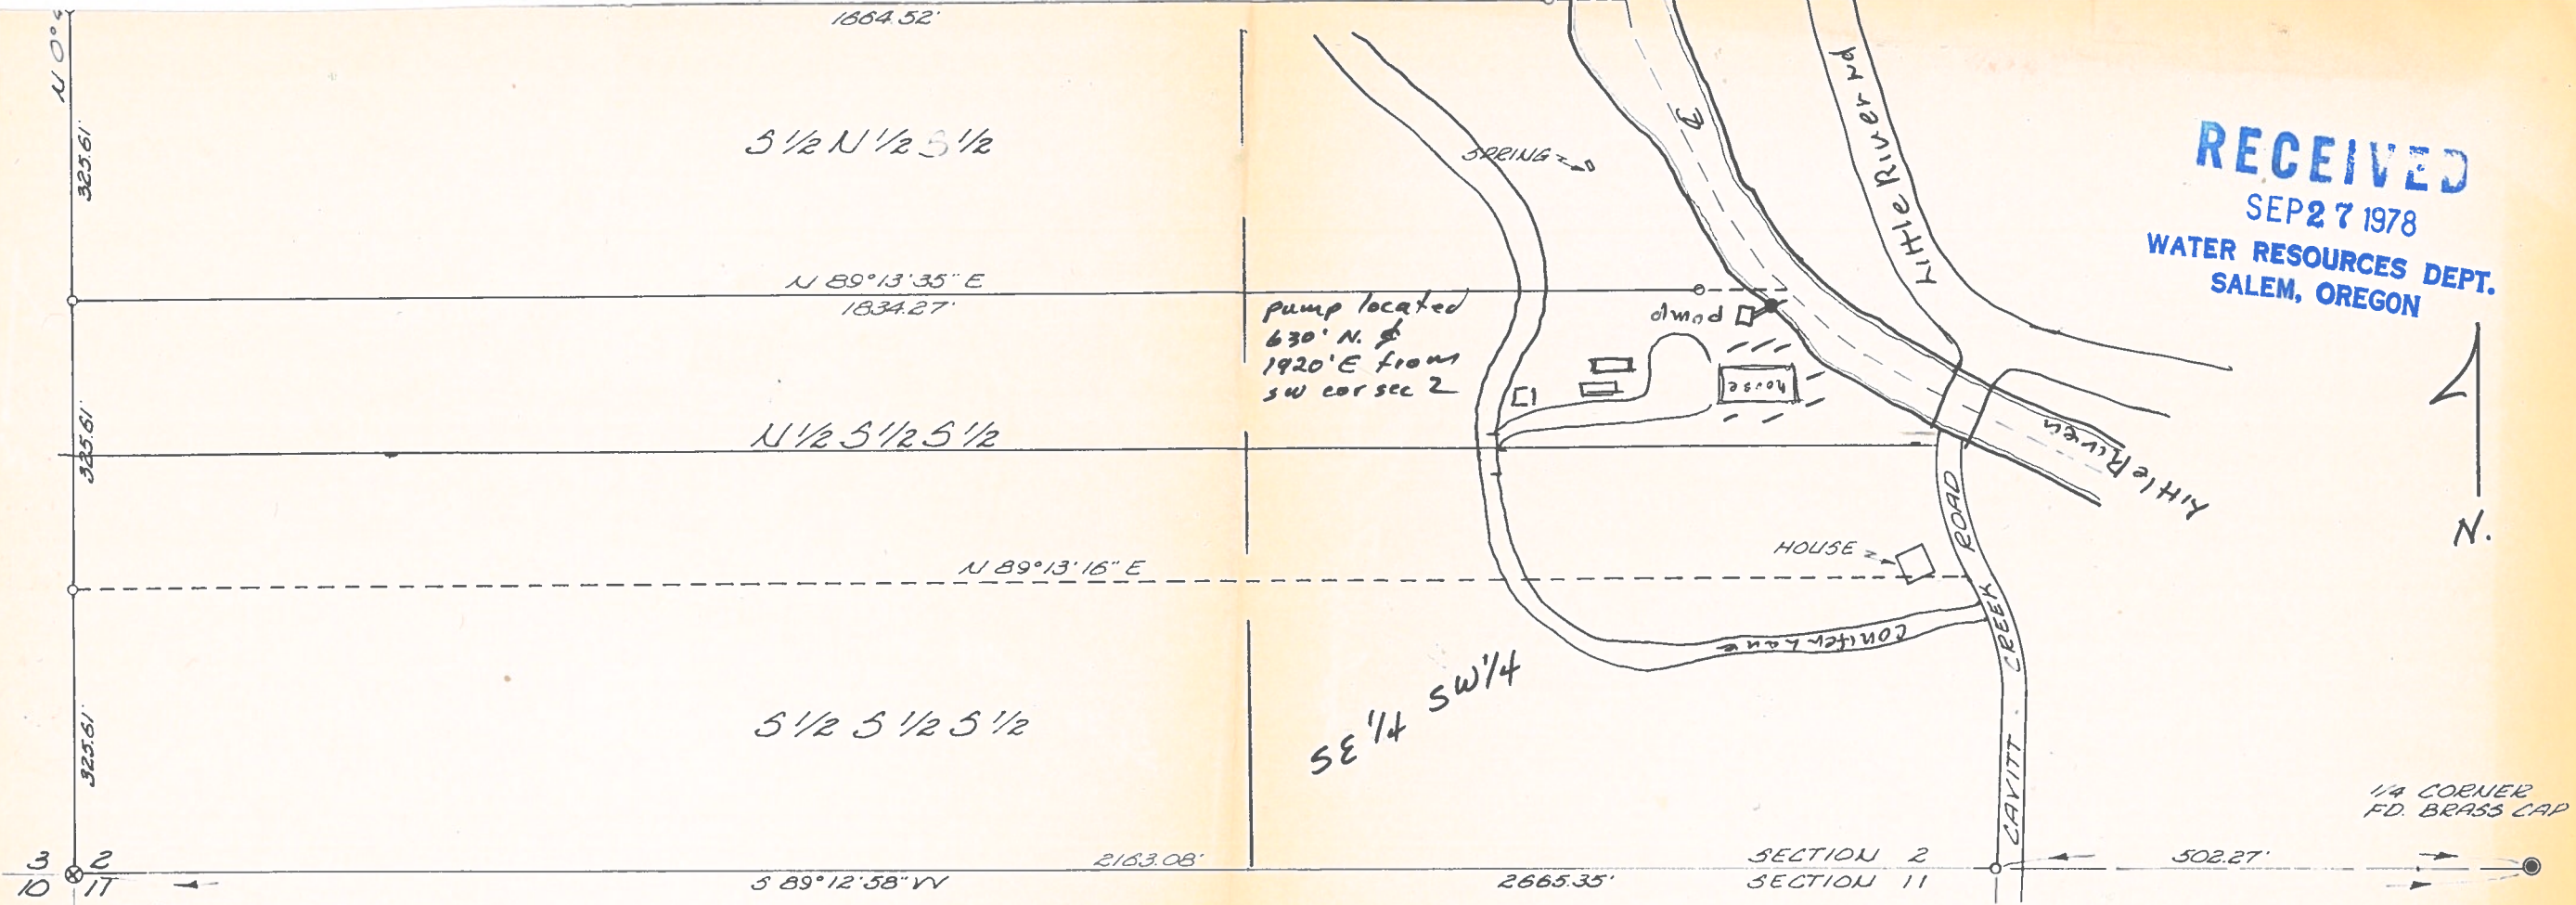

SECTION CORNER  
FD. STONE  
B.T.'s FD.  
12" FIR- N59°E-39 LKS.  
27" FIR- N12 1/2°1V-55 LKS.

1/4 CORNER  
FD. BRASS CAP

Application No. 57956  
Permit No. 43596

Application No.  
Permit No.

T. 27 S. R. 3 W.

1" = 200'

M37-54