


Permit: S 43669
Volume: 7
Strm: MURPHY CR
Trib: APPLGATE R
Priority: 9/05/78

T. 37 & 38 S., R. 6 W., W. M.

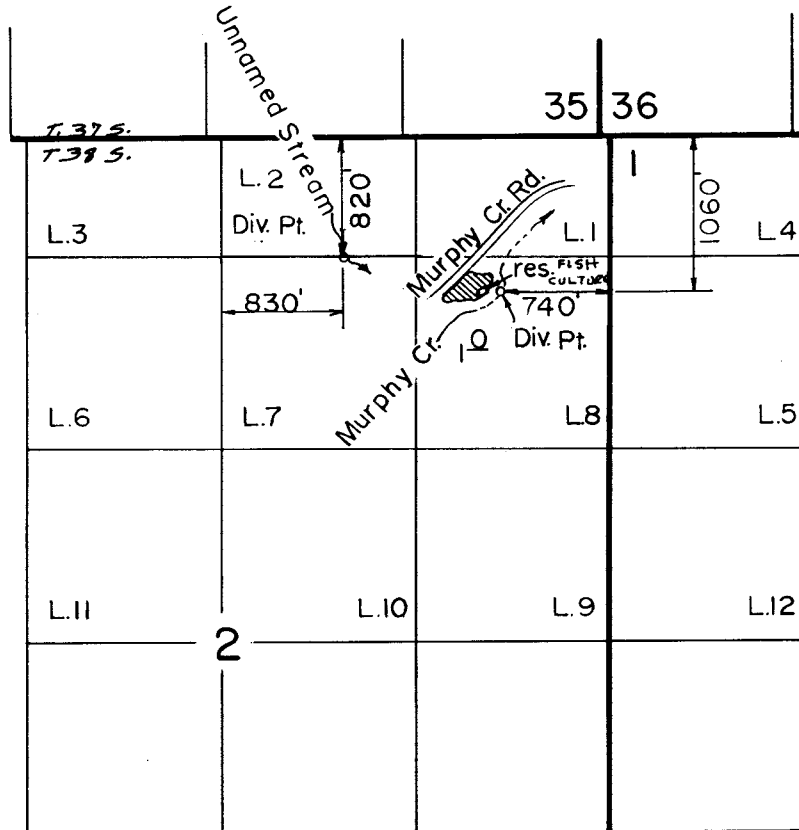

RECEIVED

JUL 18 1991

WM. DIST. 14
GRANTS PASS, ORE.

Scale: 1" = 1320'

FINAL PROOF SURVEY

UNDER

R-64775 R-8653

64776 47522

Application No. 57893 Permit No. 43669

IN NAME OF

JOHN & CAROLINE BERKMAN

Surveyed MAY 24, 1988, by B. S. JAMES