


RECEIVED

JUL 14 1978

WATER RESOURCES DEPT.
SALEM, OREGON

T. 23 S. R. 13 W. W.M.
1" = 200'

James A. Smejkal

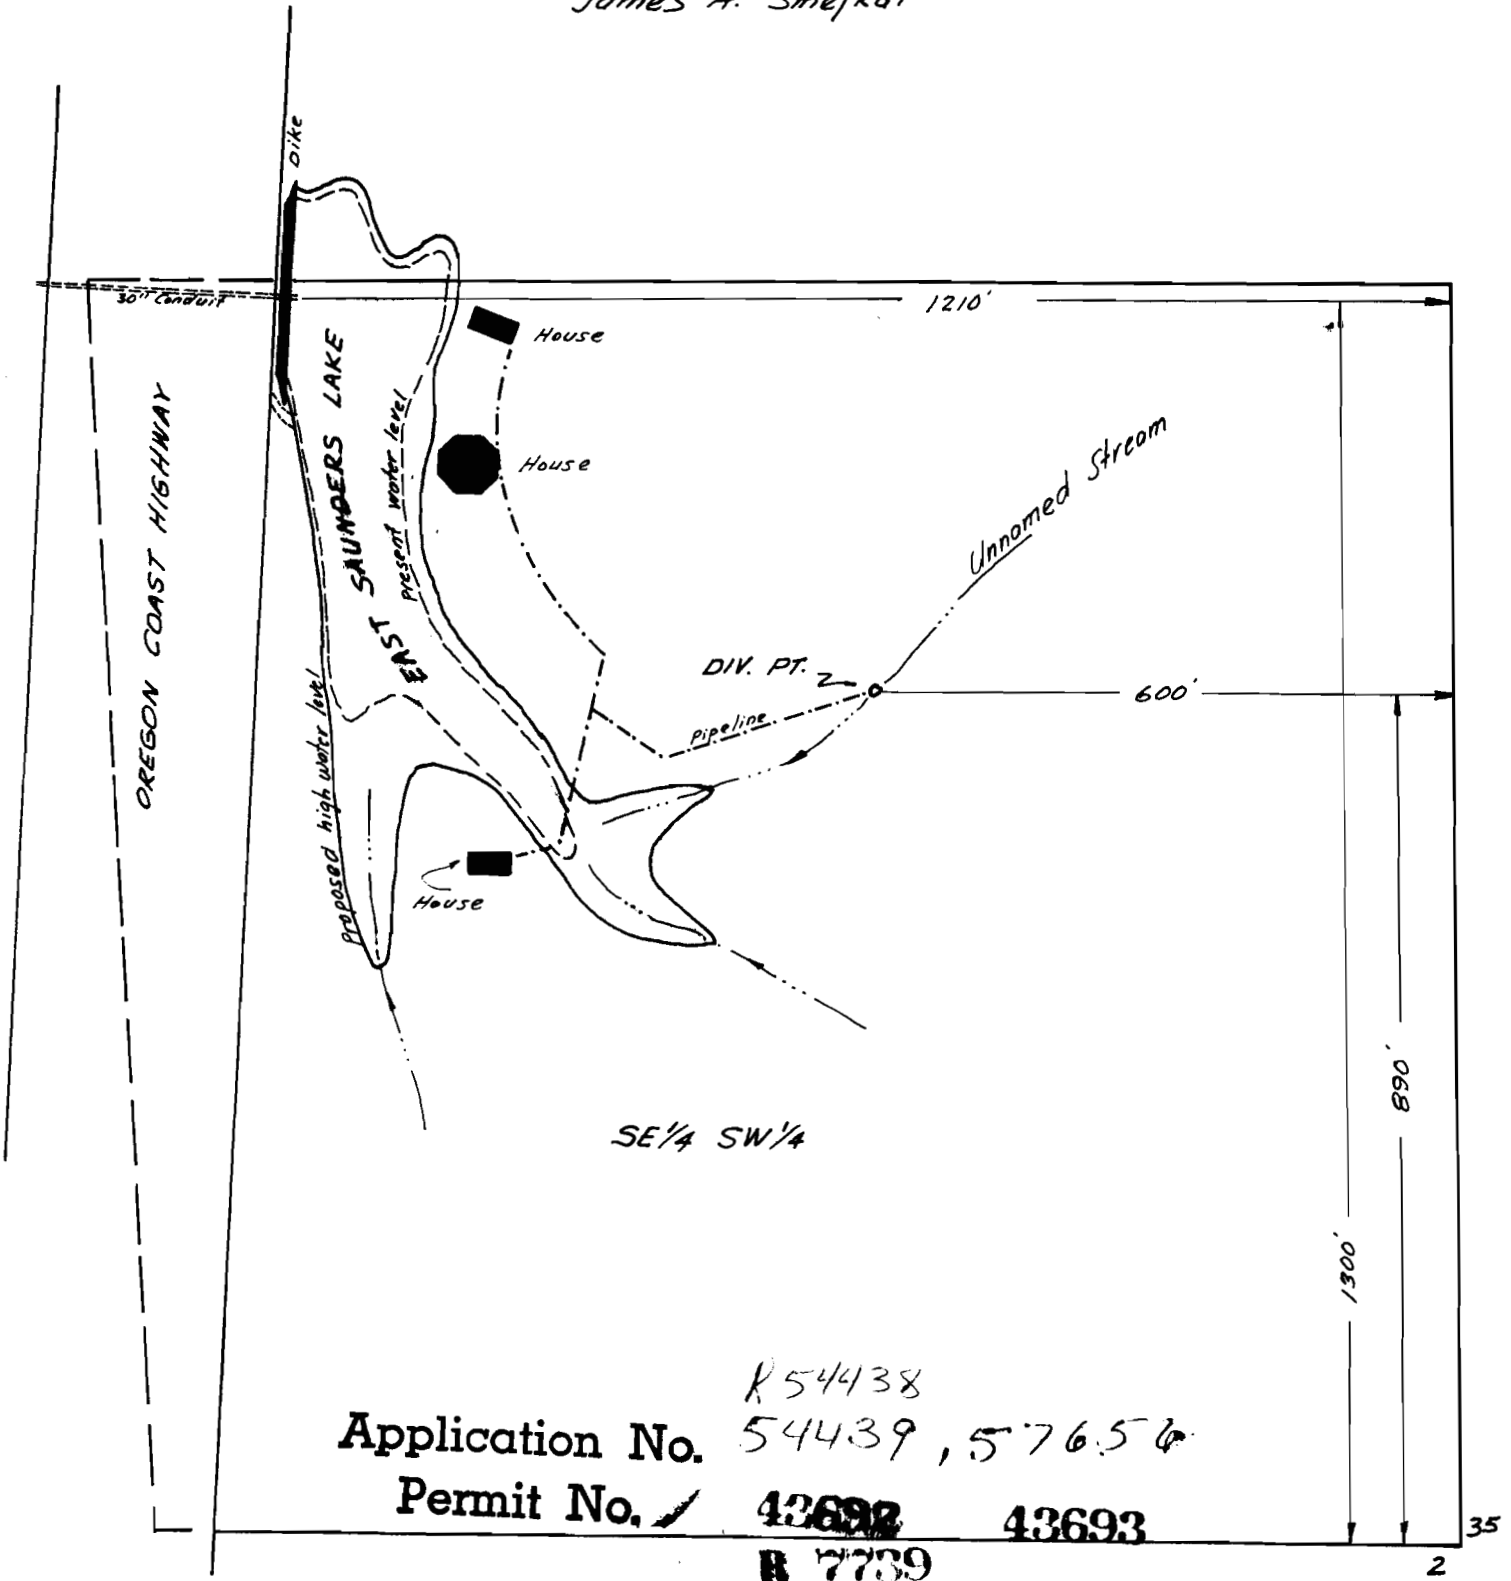

Application No.

R 54438
54439, 57656

Permit No.

43692 43693

R 7739