


Application No. 58110

Permit No. 43750

T 32 S R 15 W  
Portion of NE 1/4 NE 1/4  
Sec 35

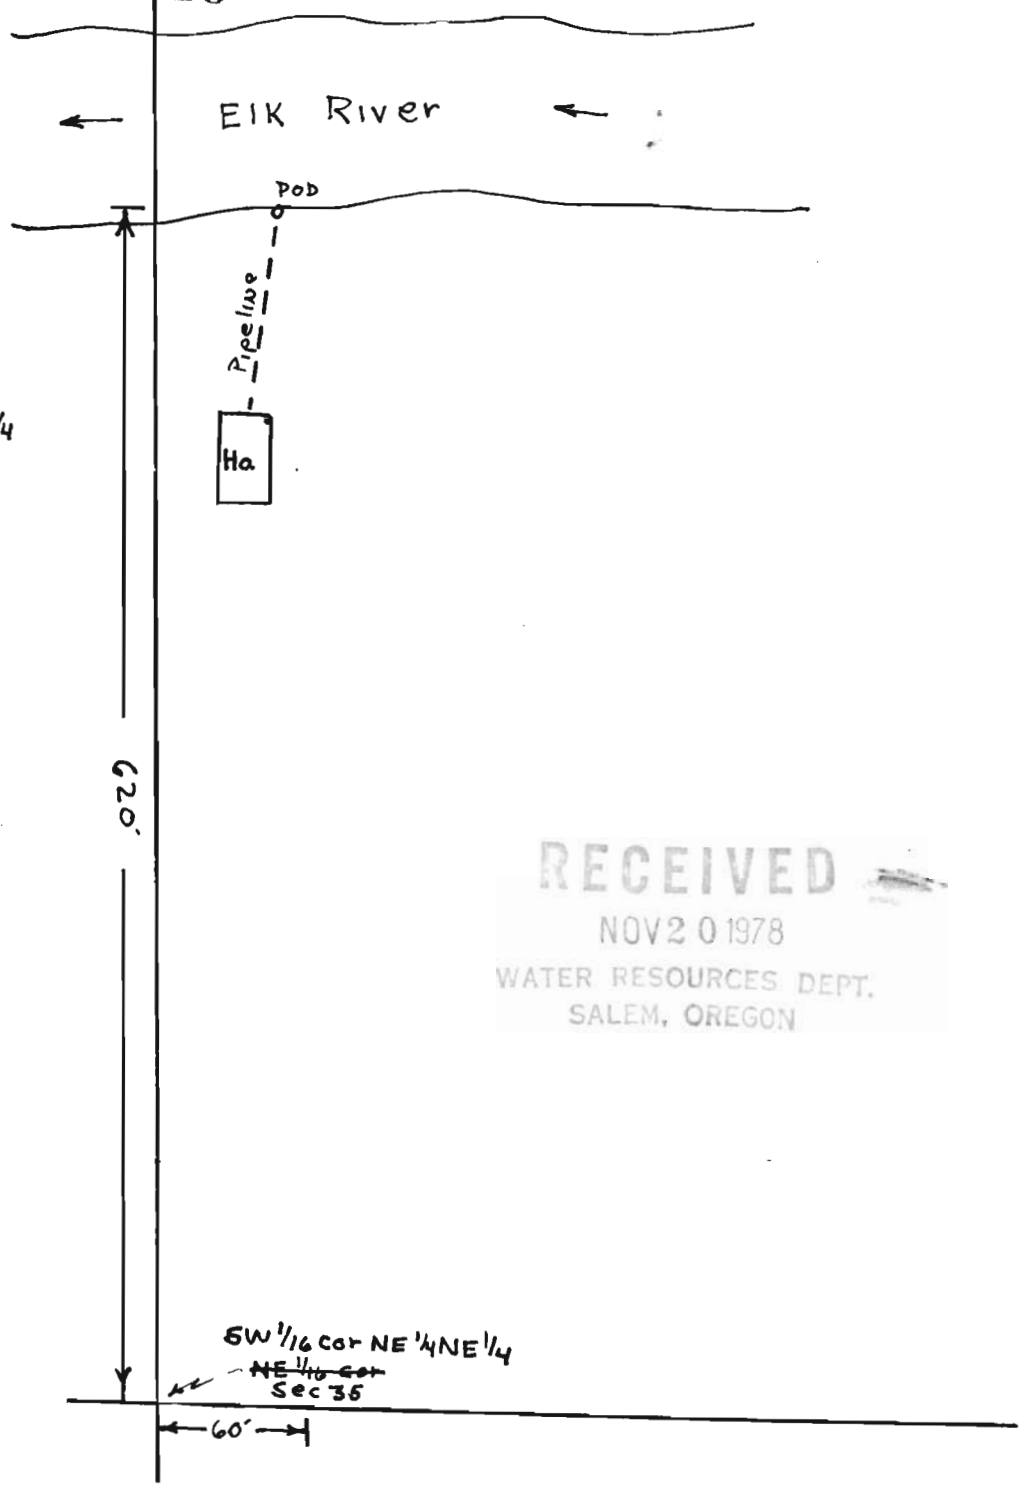

RECEIVED  
NOV 20 1978  
WATER RESOURCES DEPT.  
SALEM, OREGON