


Application NO. 00012

# Permit No. 43751

T25S R12W  
Sec 35

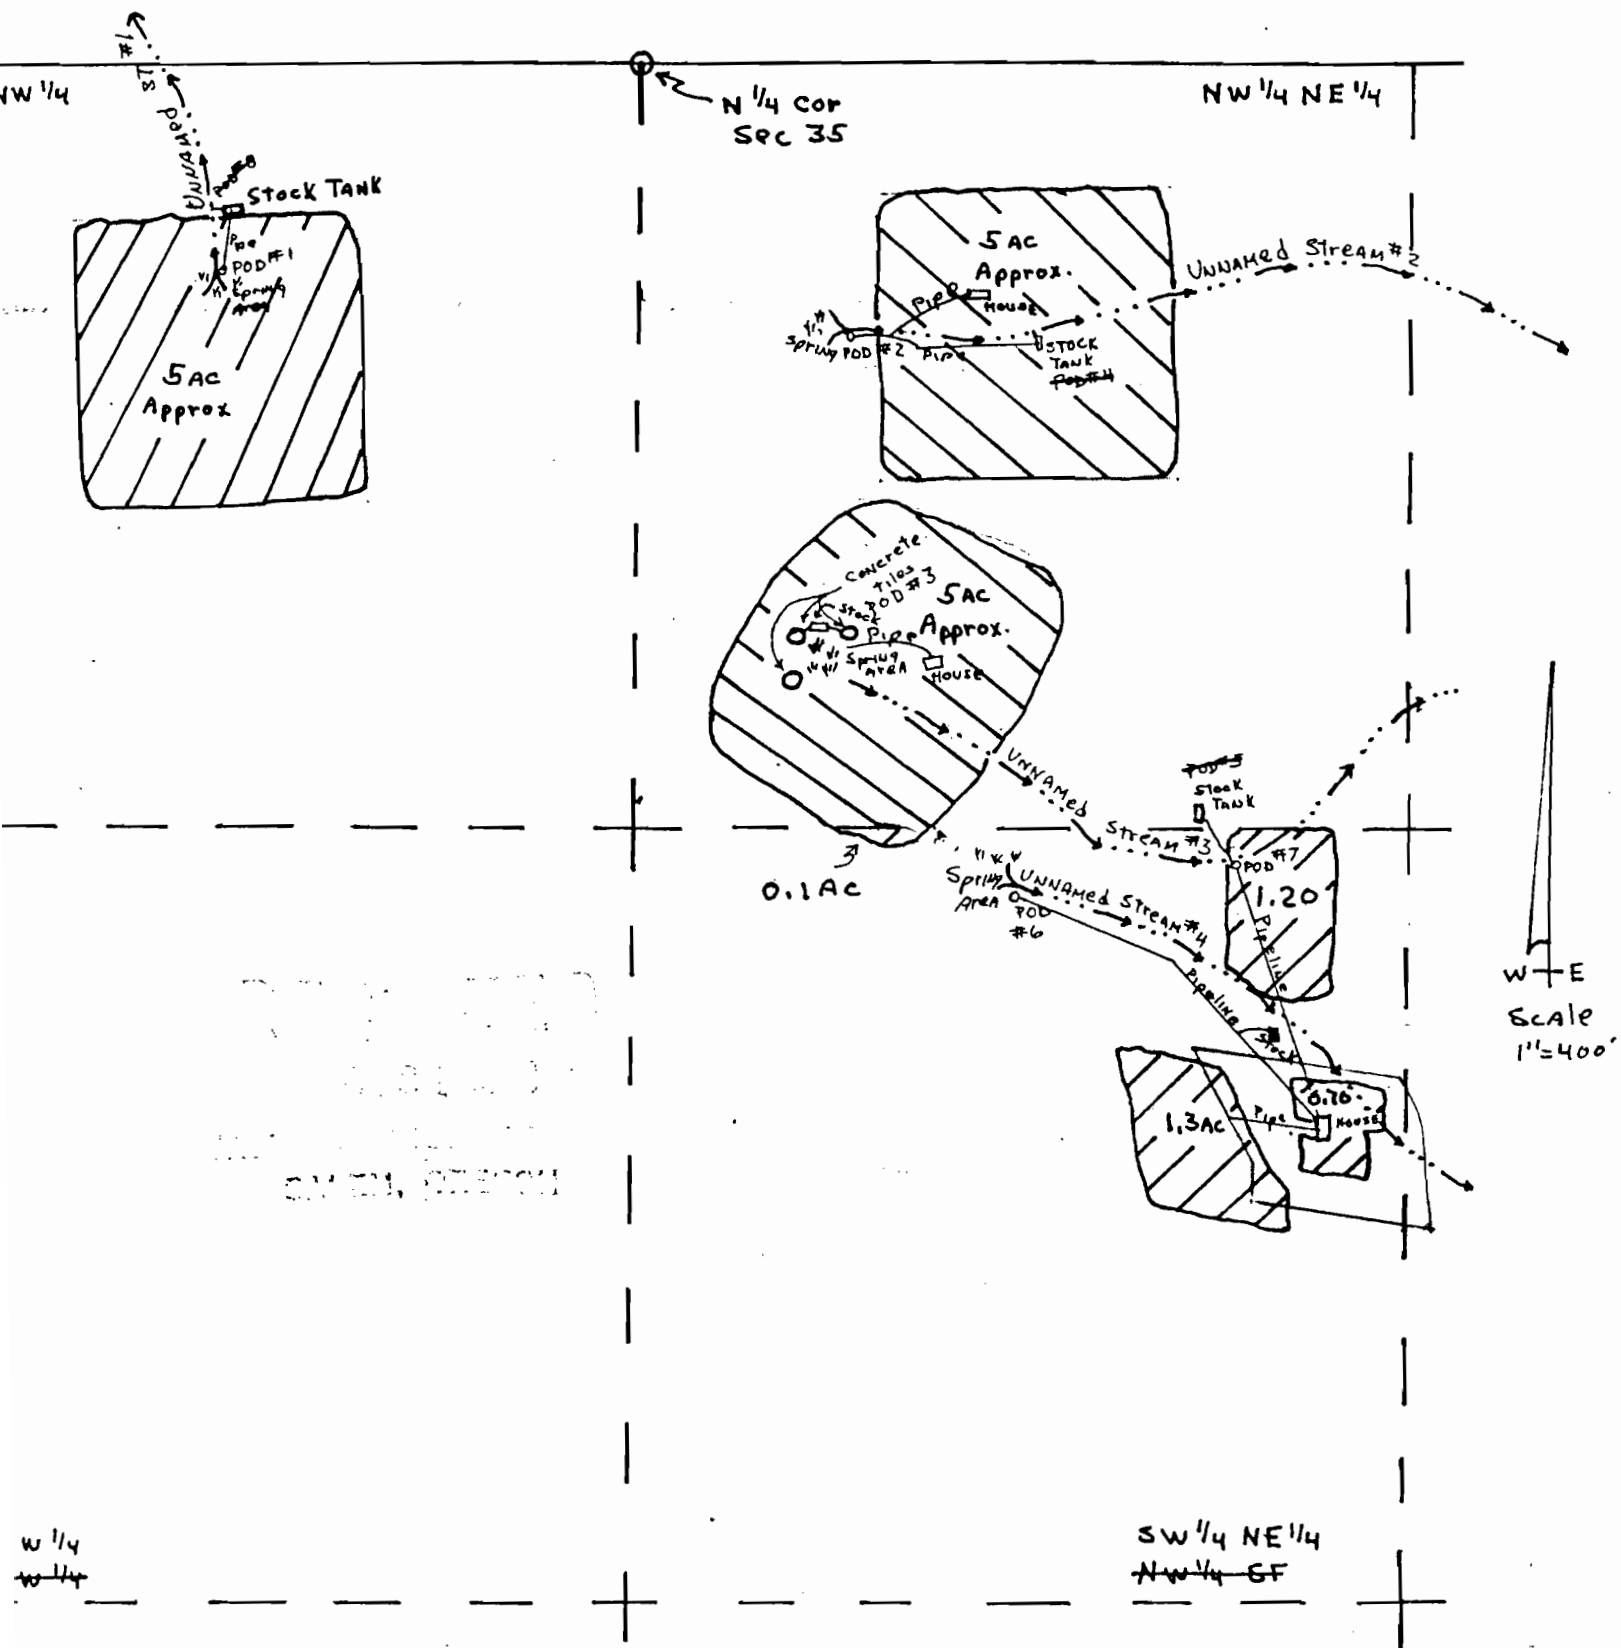

W T E  
Scale  
1"=400'

W 1/4  
W 1/4

SW 1/4 NE 1/4  
NW 1/4 SE