




TRANSAMERICA TITLE
INSURANCE COMPANY

OR
CURRY COUNTY

THIS SKETCH IS MADE TO ASSIST
IN PROPERTY LOCATION, AND THE
COMPANY ASSUMES NO LIABILITY
FOR ANY VARIATION IN DIMEN-
SIONS OR LOCATION ASCERTAIN-
ABLE BY ACTUAL SURVEY.

See Exhibit "A"
attached for legal
description of property

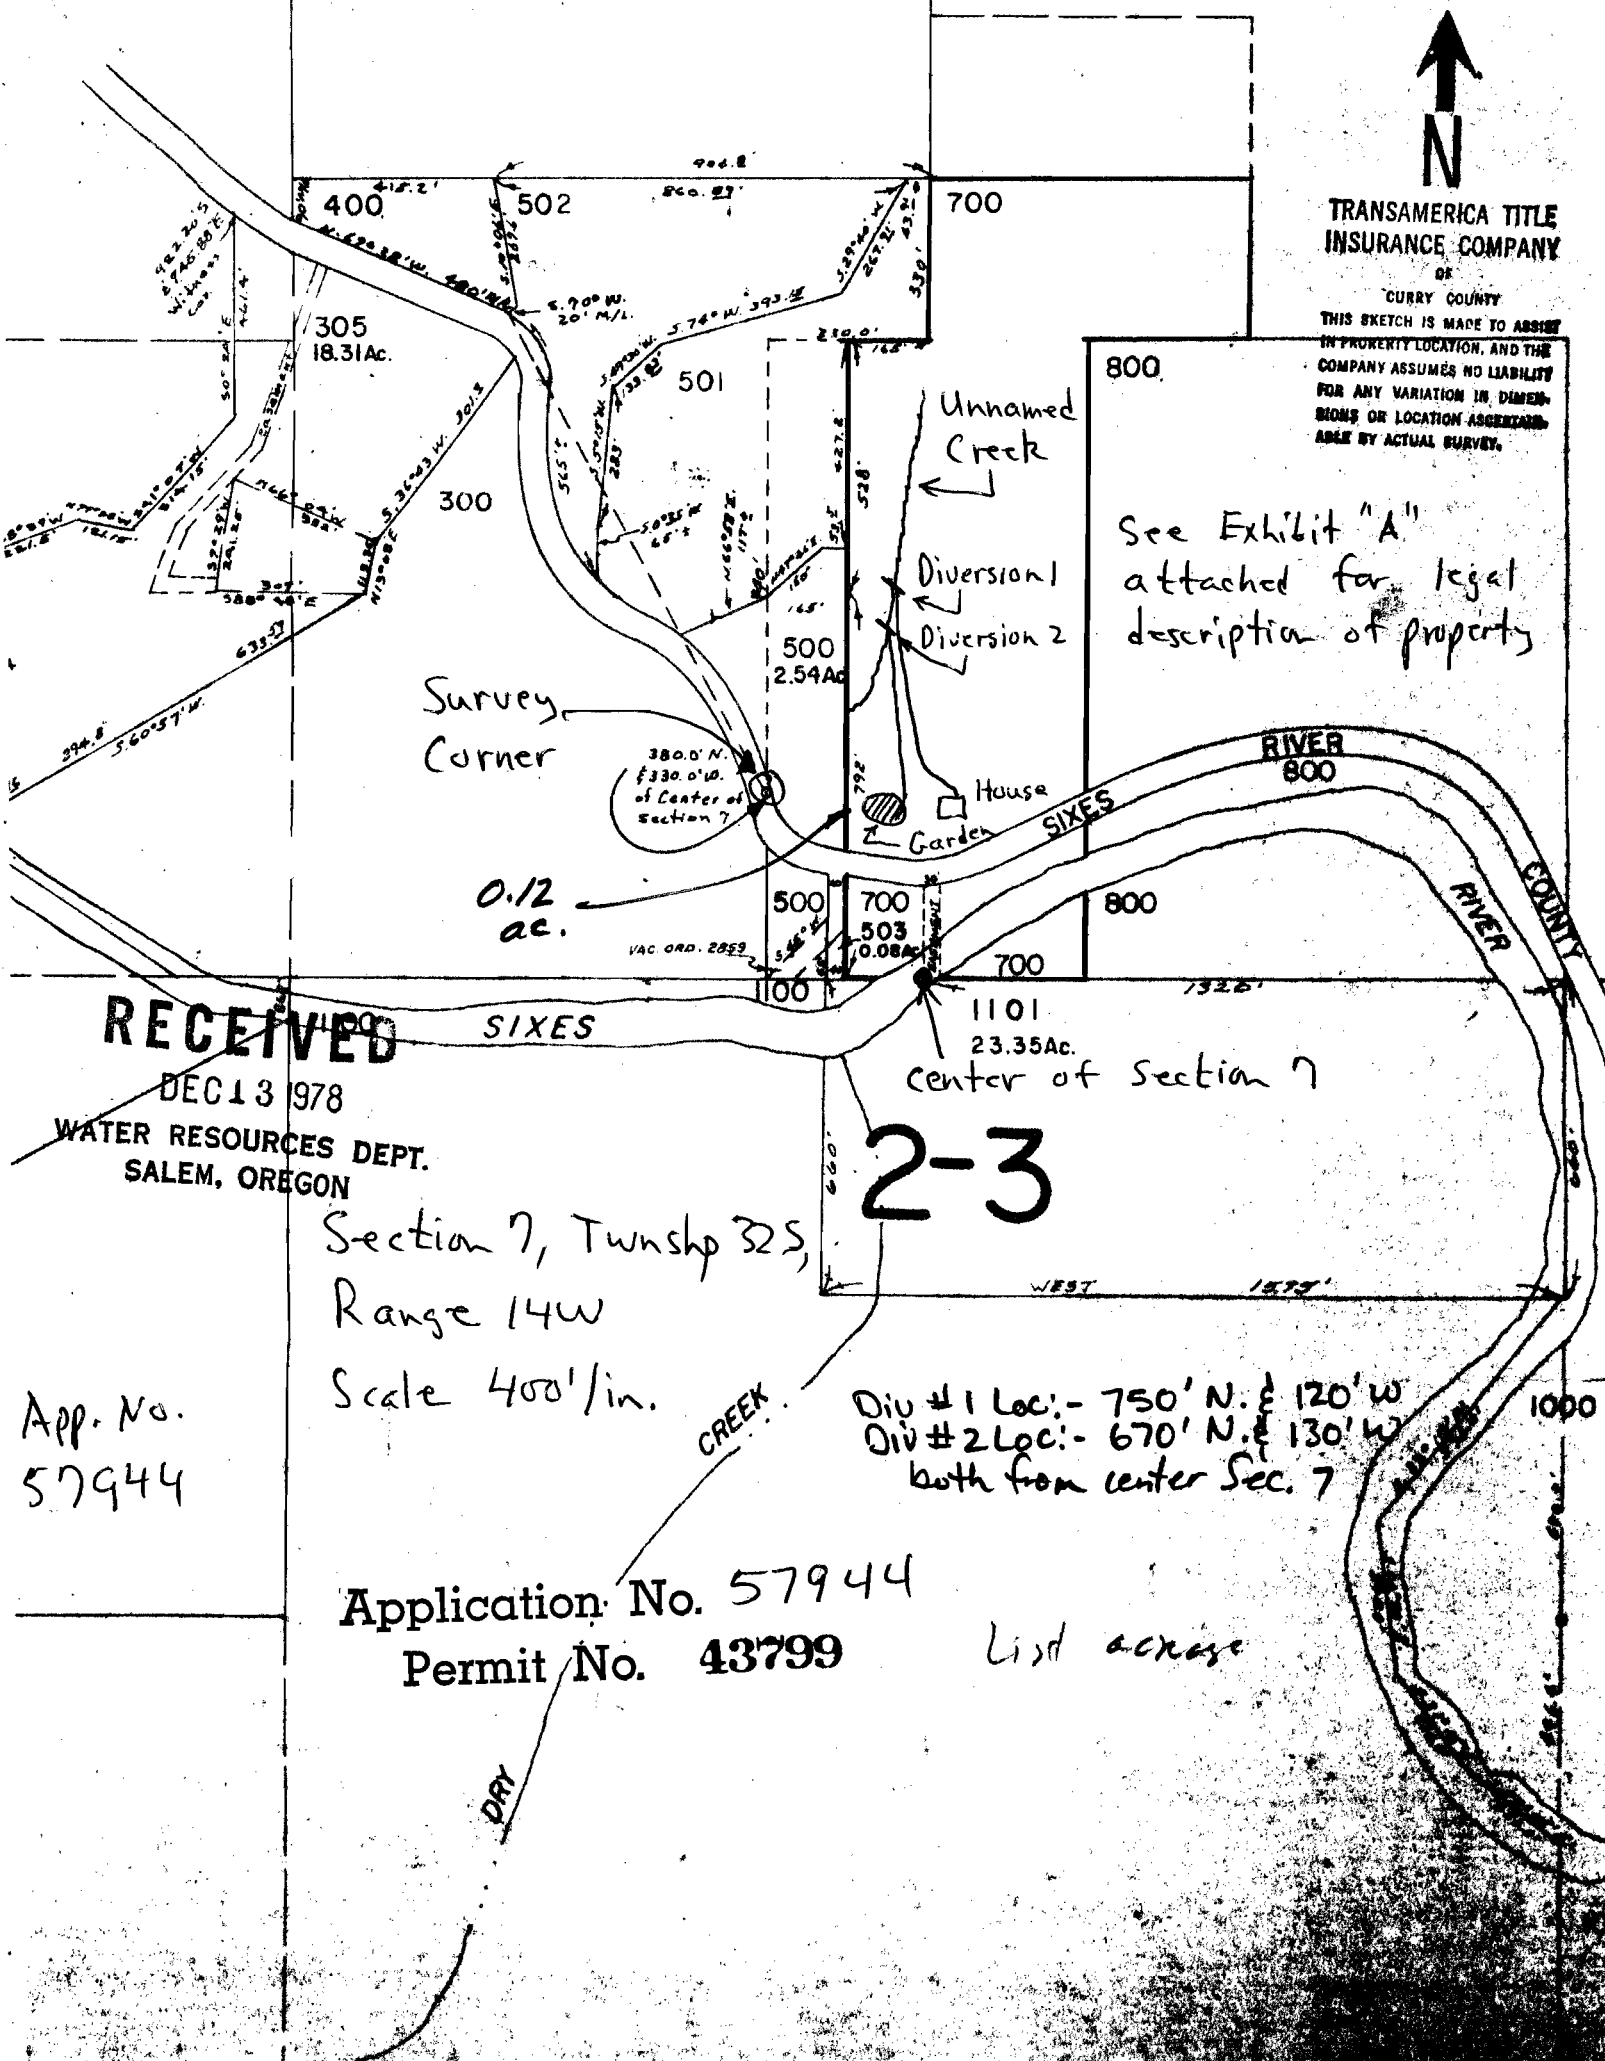

RECEIVED

DEC 13 1978

WATER RESOURCES DEPT.
SALEM, OREGON

Section 7, Twnshp 32S,
Range 14W

Scale 400'/in.

Application No. 57944

Permit No. 43799

List acreage

Div #1 Loc: - 750' N. & 120' W.
Div #2 Loc: - 670' N. & 130' W.
both from center Sec. 7

App. No.
57944