


T26S R12W
SE 1/4 NE 1/4
Sec 30

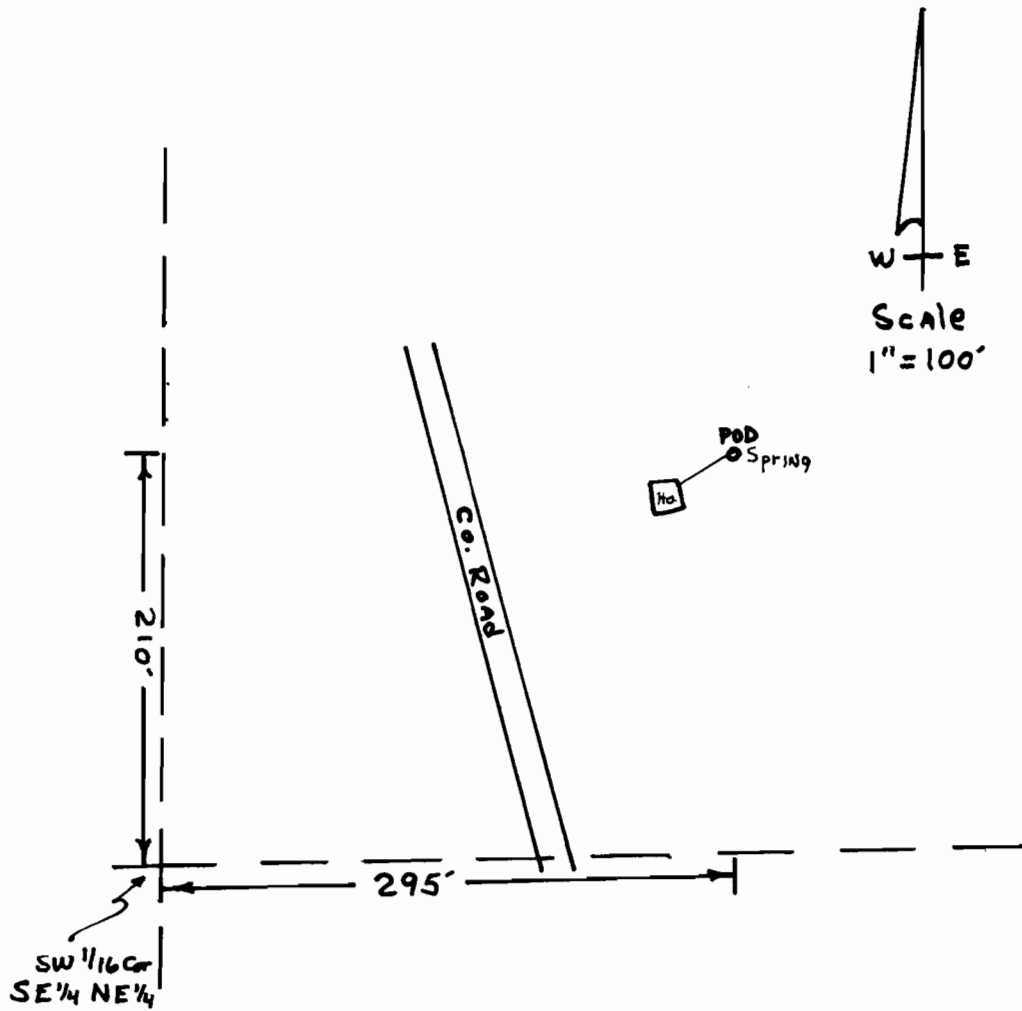

Application No. 58149
Permit No. 43852