

The sketch below is made solely for the purpose of assisting in locating said premises and the Company assumes no liability for variations, if any, in dimensions and location ascertained by actual survey.

Pioneer National Title Insurance Company
A TICOR COMPANY

RECEIVED

JUL 13 1978

WATER RESOURCES DEPT.
SALEM, OREGON

RECEIVED

FEB 14 1979

WATER RESOURCES DEPT. - I.S.-8.
SALEM, OREGON

Application No. 57644
Permit No. 43860


N 82° E

2750'

SR-15-8W

*Spring is N 82° E a distance
of 750' from the SW corner
of the NW 1/4 of the NW 1/4 of Sec 12*

1" = 400'

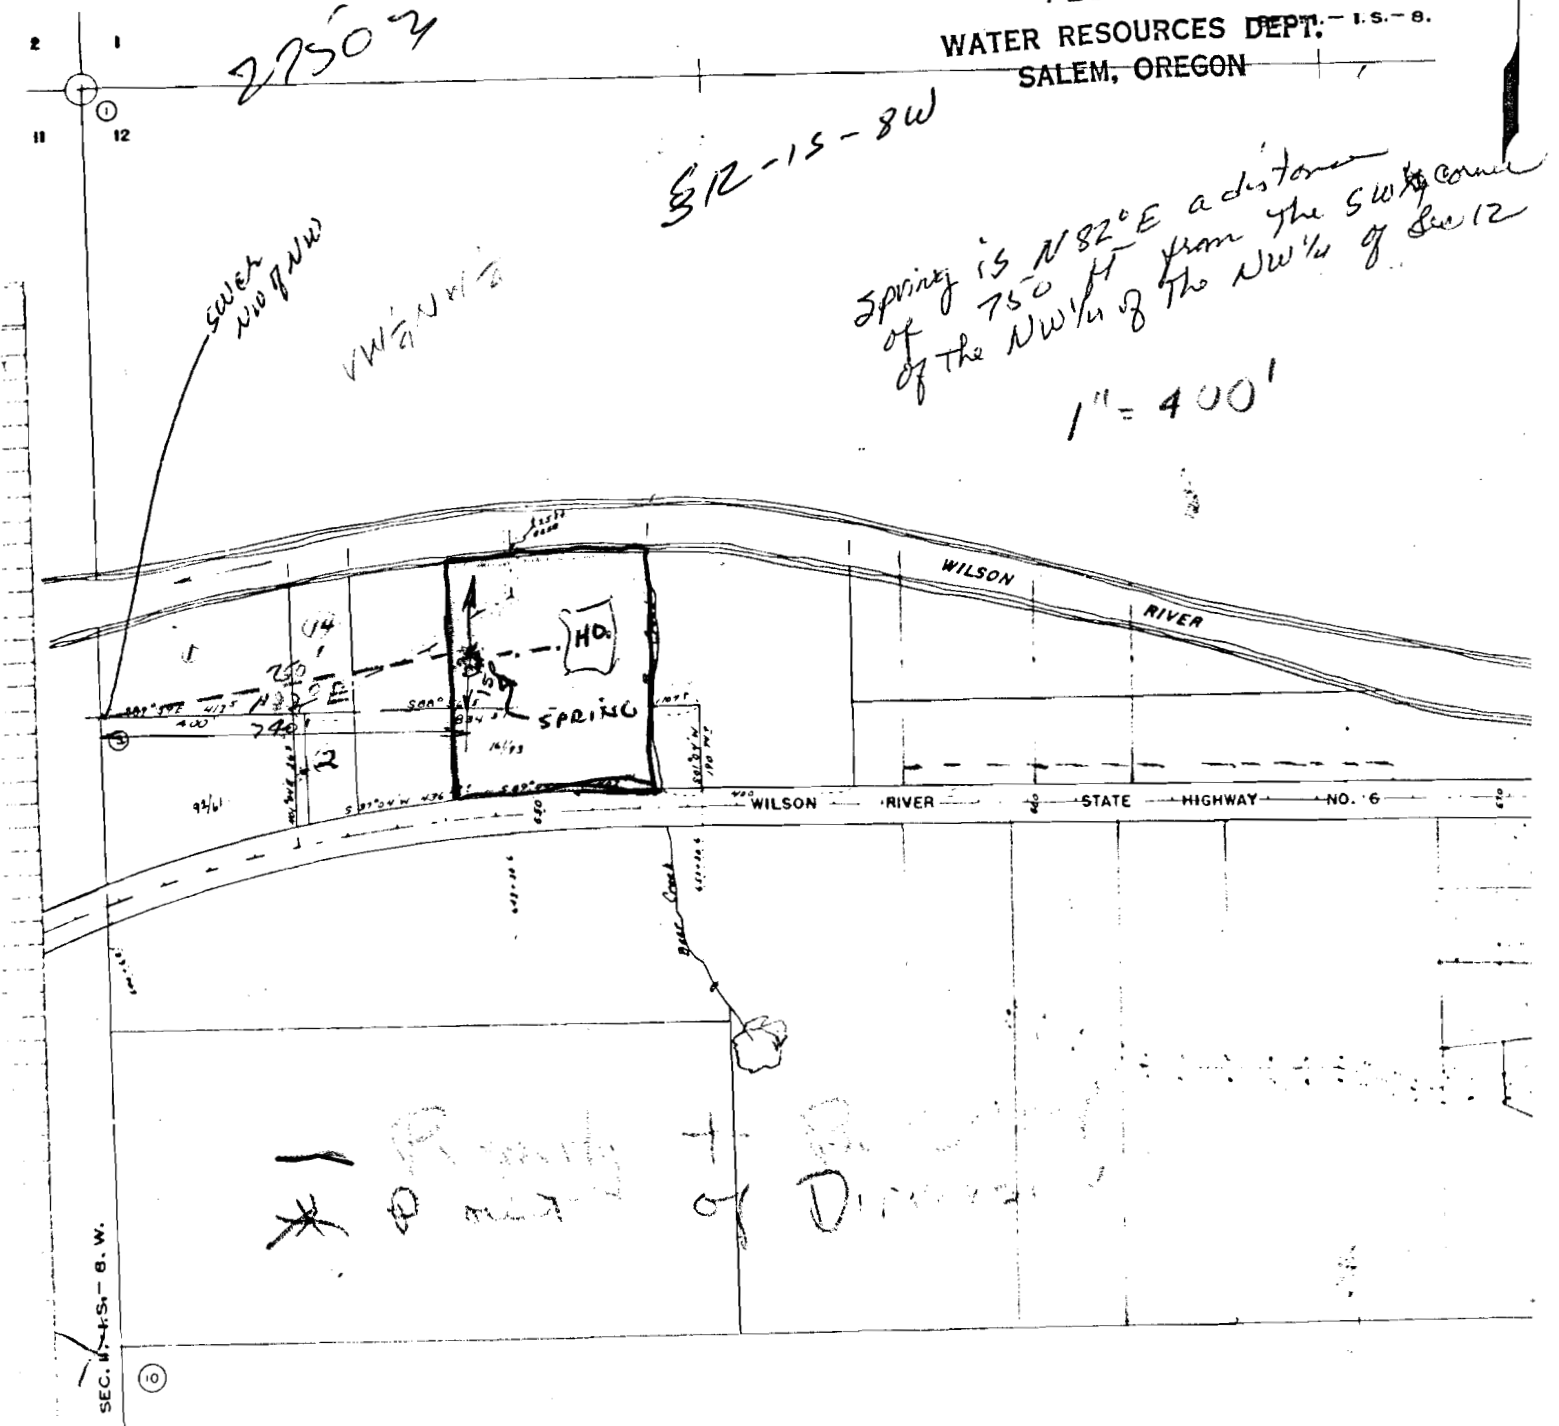

Property of District