


T. 36 S., R. 6 W., W. M.

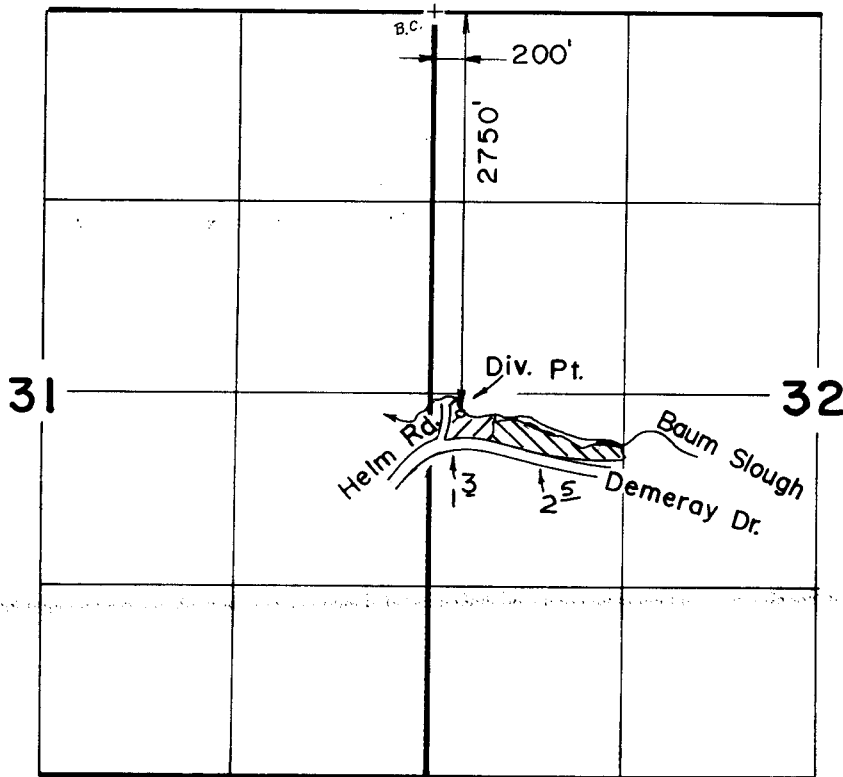

RECEIVED
 AUG 31 1990
 WM. DIST. 14
 GRANTS PASS, ORE.

Scale: 1" = 1320'

Primary



Supplemental



FINAL PROOF SURVEY UNDER

Application No. **57785** Permit No. **43888**
 IN NAME OF

RICHARD OLSON

Surveyed Sep. 21, 1987, by B. S. JAMES