

Application No. 58117

Permit No. 43917

Sec 2 T 19 S R 12 W W M

1" = 200'

RECEIVED

NOV 24 1978

WATER RESOURCES DIV  
SALEM, OREGON

Sims' Prop.


Birch Street

1/4 Cor  
N 1/4 Cor  
Sec 2

Water  
line

Spring  
473' S. & 20' W  
from 1/4 Cor  
 $\frac{35}{2}$

See Map 19 12 02 1

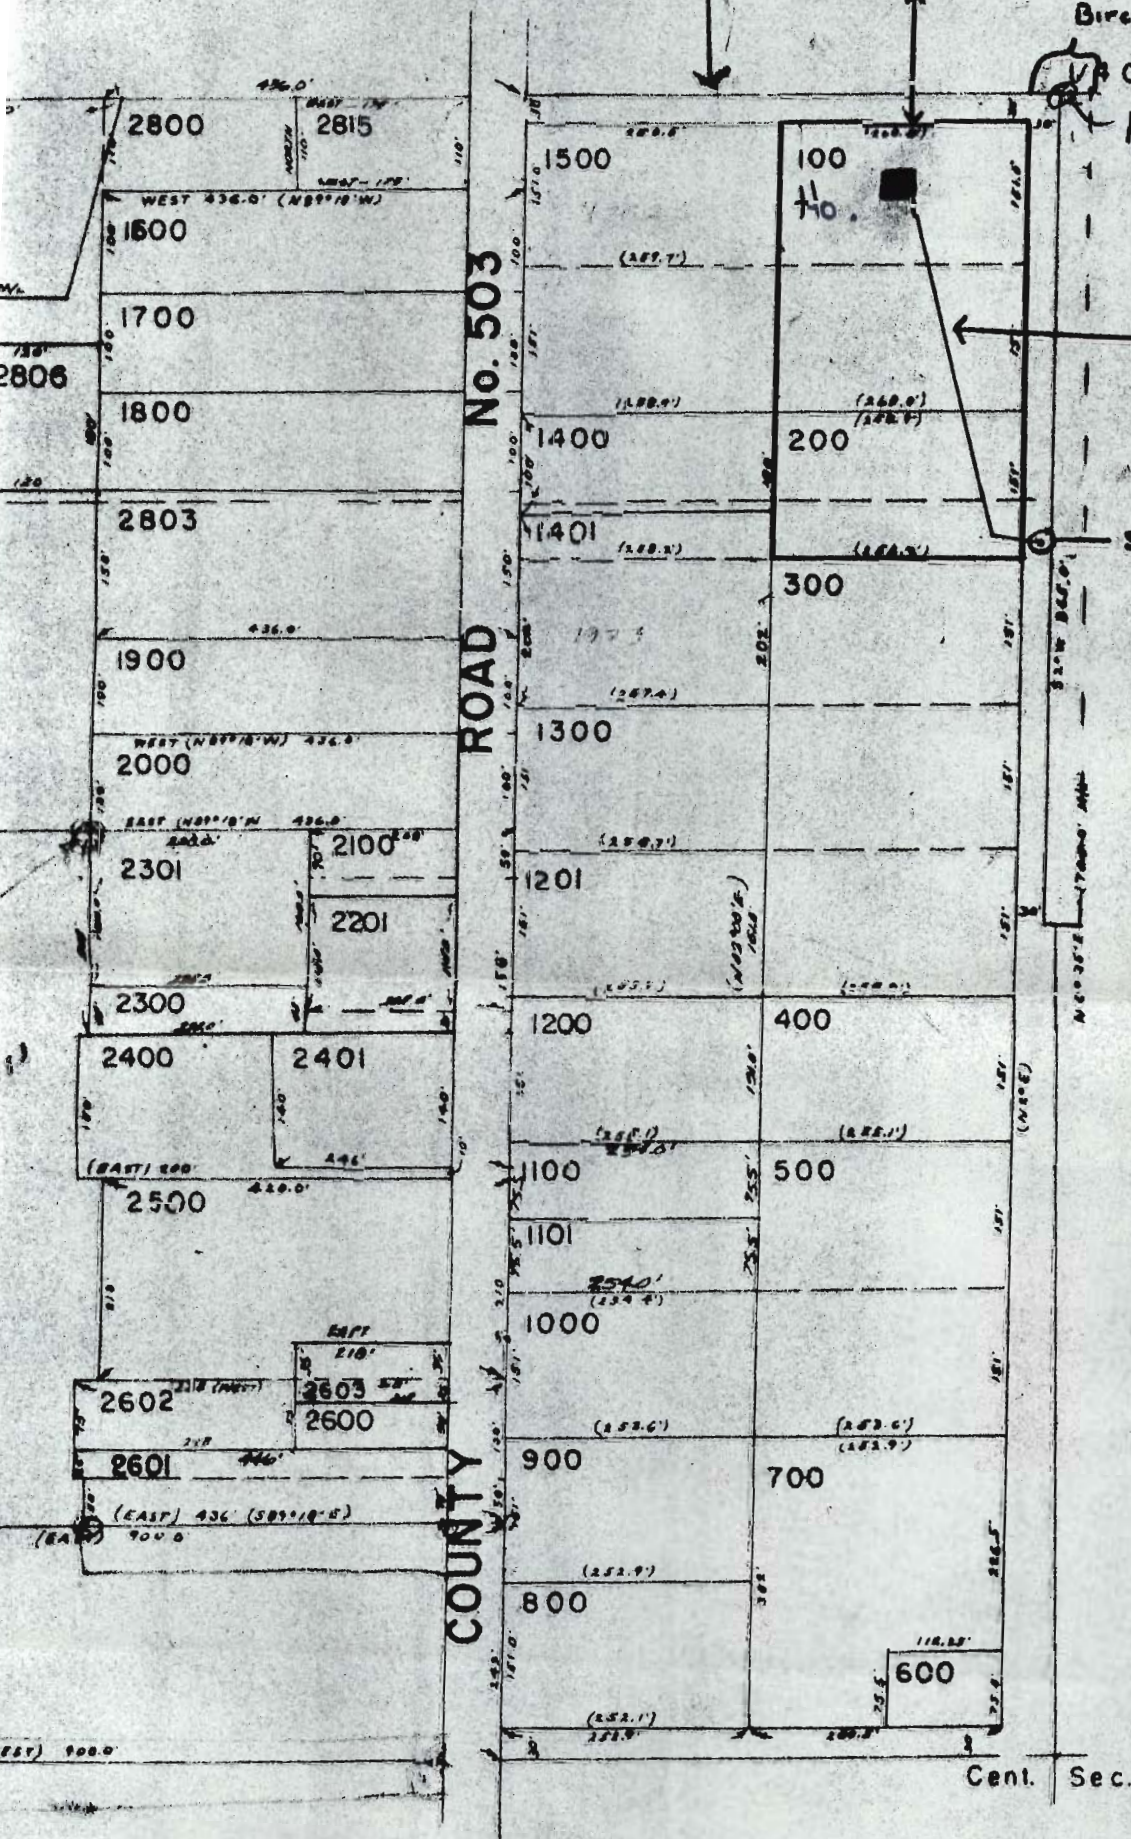

See Map 19 12 02 3 1

Spring & Water Line

W.E. Sims & Yvonne Sims

Water Rights Appl. Nov. 17, 1978