


Application No. 58177  
 Permit No. 43944  
 R-58176  
 R-7800  
 T. 31 S. R. 4 W. W.M.

RECEIVED  
 FEB 14 1979  
 WATER RESOURCES DEPT.  
 SALEM, OREGON

Section 28

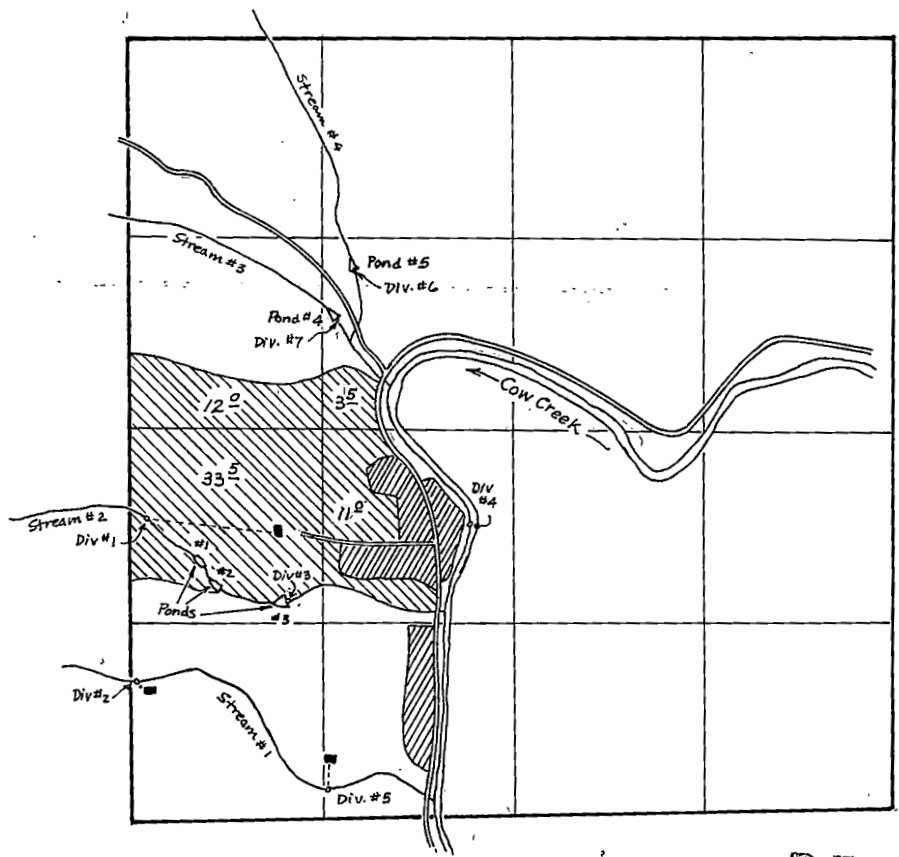

RECEIVED  
 DEC 12 1978  
 WATER RESOURCES DEPT.  
 SALEM, OREGON

Scale: 4" = 1 mile



Portions of P# 19730



New Irrigation

- Div #1: 630'S and 120'E
  - Div #2: 1730'S and 40'E
  - Div #3: 1190'S and 1100'E
  - Div #4: 640'S and 2350'E
  - Div #5: 2470'S and 1360'E
  - Div #6: 1080'N and 1550'E
  - Div #7: 740'N and 1440'E
  - pond #1 940'S. 630'E
  - pond # 1100'S. 630'E
- } All from W 1/4 cor. Sec. 28

315 AW  
sec 28

21

22

23

Cow Creek

cert 9609

4 Ac NWSW

Streams except in the irrigated land sketched approximate location

28

27

26

12 CREEK

R.R. Rhust

09

12

Spring

22

John Abro

Clarence Abro

MCGINNIS CREEK

J.W. McGinnis

02 COW

Levi Spaulding

AM...

5-7-76

→ DOUGLAS CO. -76 11B-2

