



Application No. 58197
 Permit No. 43954

RECEIVED
 WATER RESOURCES DIVISION
 SALEM, OREGON

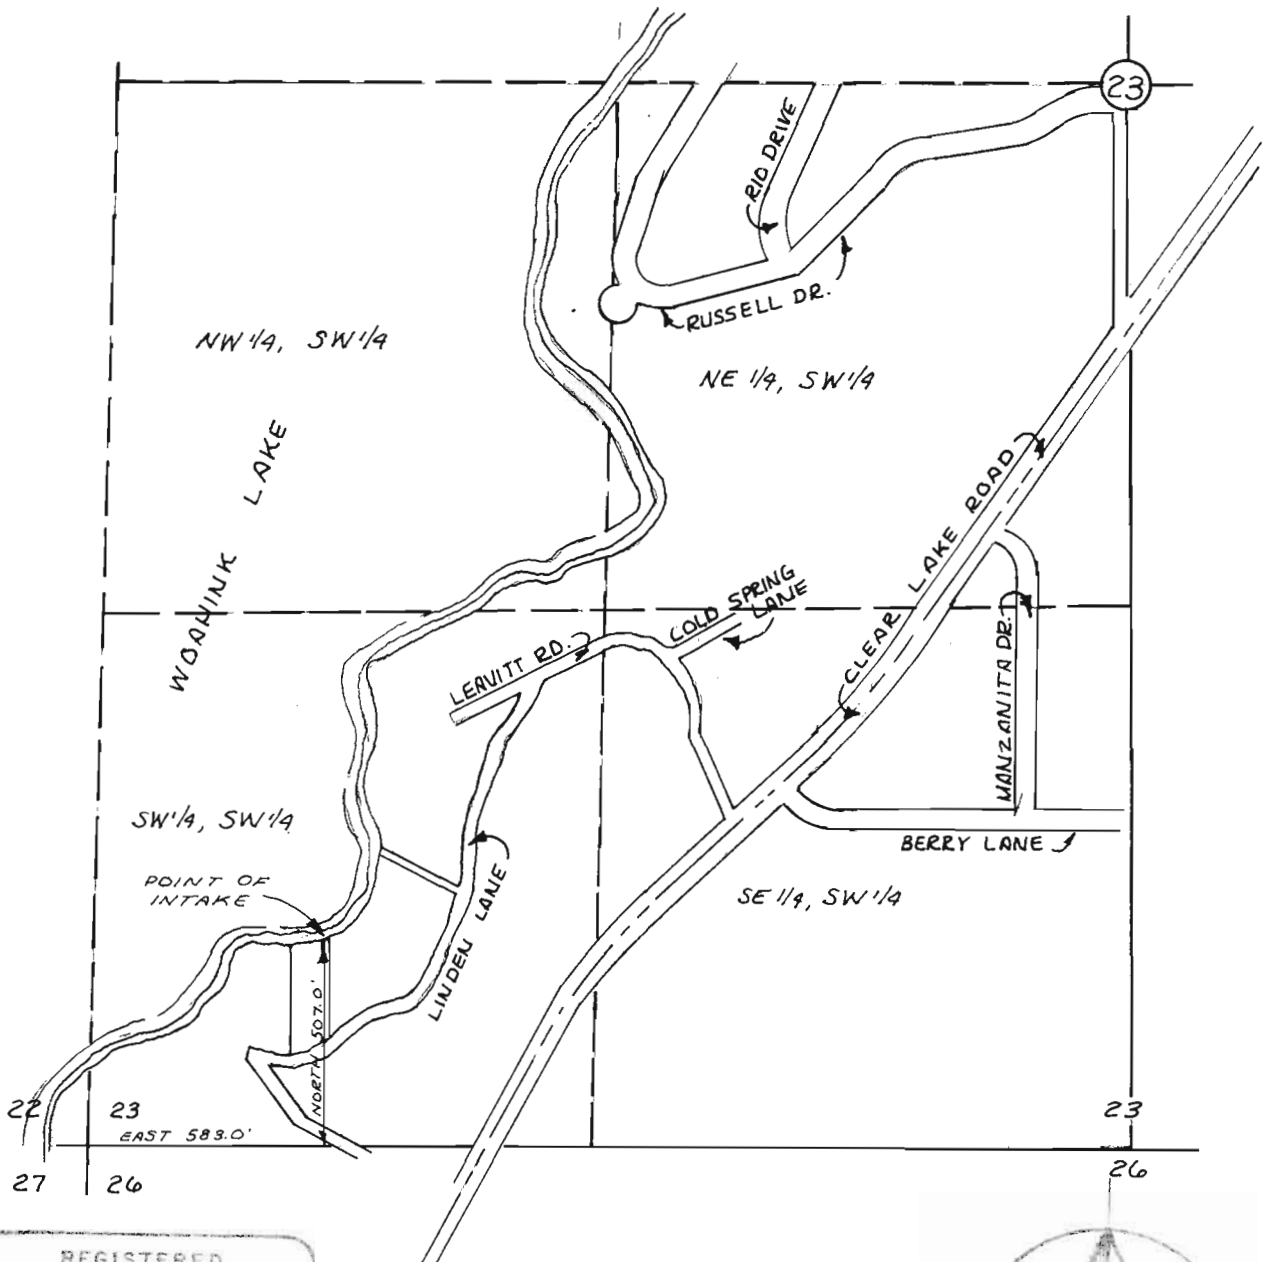

REGISTERED
 PROFESSIONAL
 LAND SURVEYOR
Eugene M. Wobbe
 OREGON
 JULY 29, 1976
 EUGENE M. WOBBE
 1093

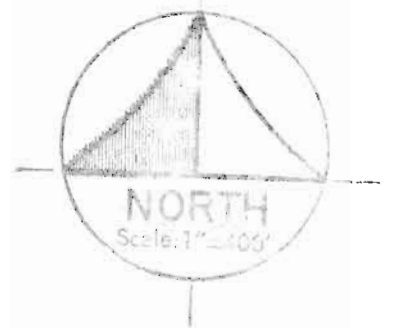

WATER RIGHTS SURVEY
 FOR
 JAMES BAUMEISTER
 SW 1/4, SW 1/4, SEC 23, T19S, R12W, W.M.
 LANE COUNTY, OREGON
 OCTOBER 1978

LEE C. PLANTS
 Professional Engineer
 510 KINGWOOD SURDEN
 P.O. BOX 1136
 FLORENCE, OREGON 97439
 (503) 927-8411