


T.37S., R.5W., W.M.

(SECTION 35)

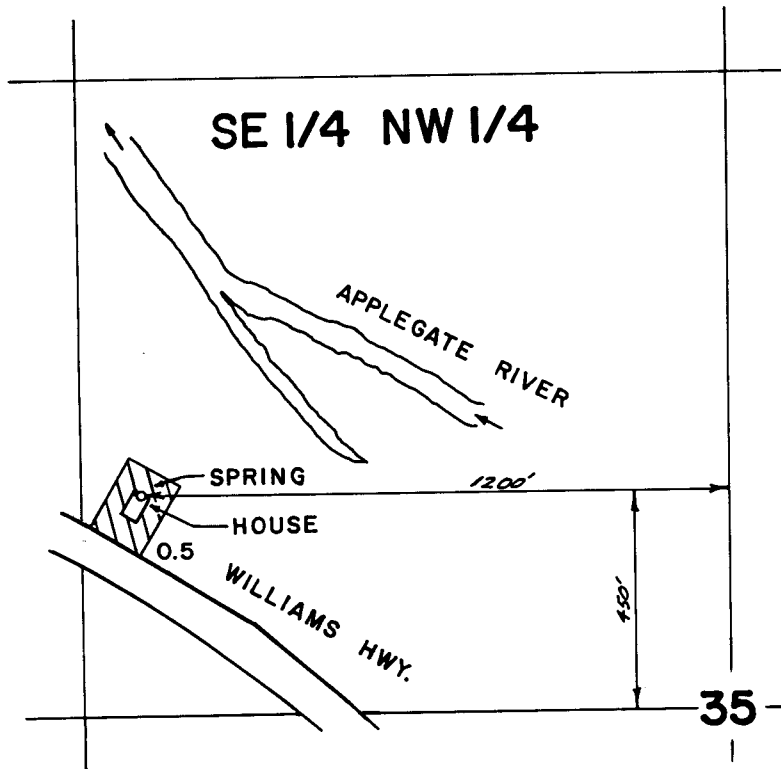

1" = 400'

FINAL PROOF SURVEY  
UNDER

Application No. 58293 Permit No. 43977....  
IN NAME OF

ORVEL D. HARRIS

Surveyed APR. 28, 1982, by B. SUND

RECEIVED

APR 1 1987

VAL. DIST. 14  
GRANTS PASS, ORG.

41033-179-110R PRP 1/31/84

by