

RECEIVED


FEB 27 1979

**WATER RESOURCES DEPT.
SALEM, OREGON**

T.13S. R.10W. W.M.

Application No. 58369

Permit No. 43991

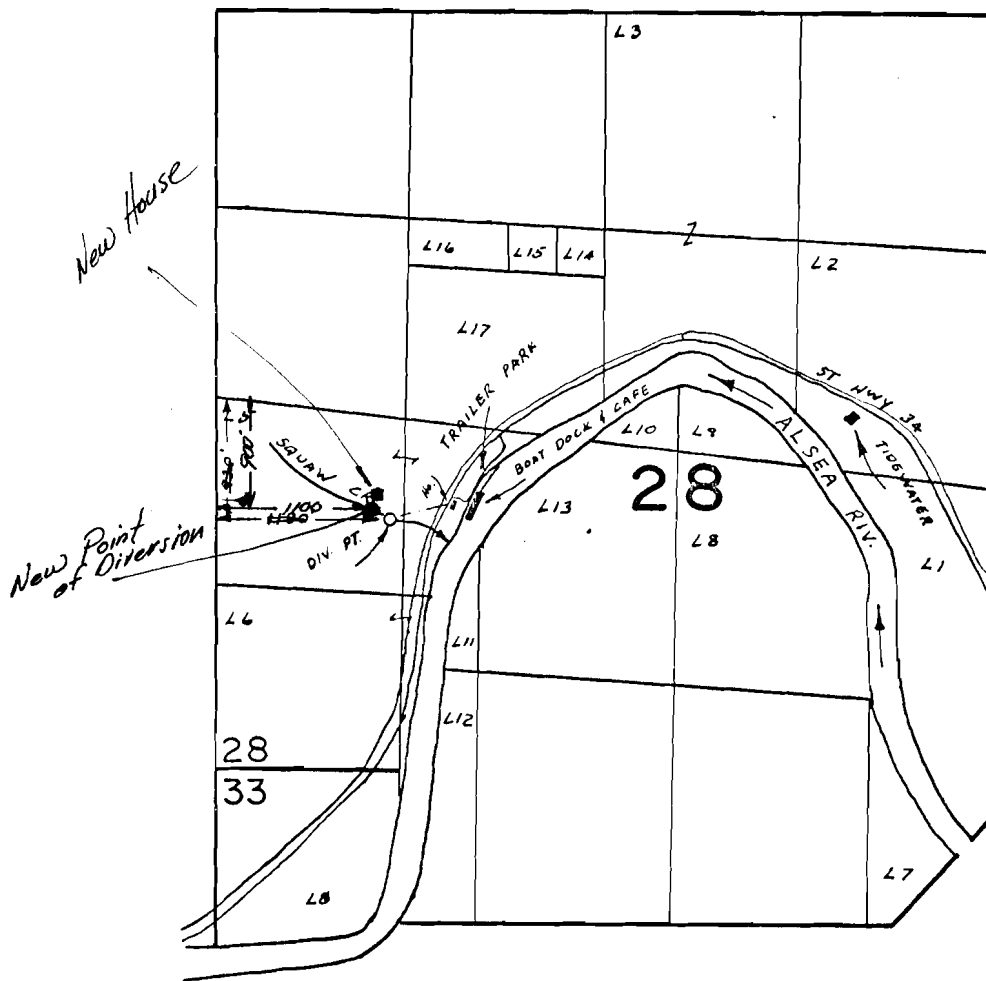

~~FINAL PROOF SURVEY~~
UNDER

Application No. ~~55577~~ Permit No. ~~30557~~
IN NAME OF

BYRON and CHARLOTTE FOWELL

Surveyed JUN. 5. 1975, by L.H. NUNN