


T.37S., R.7W., W.M.

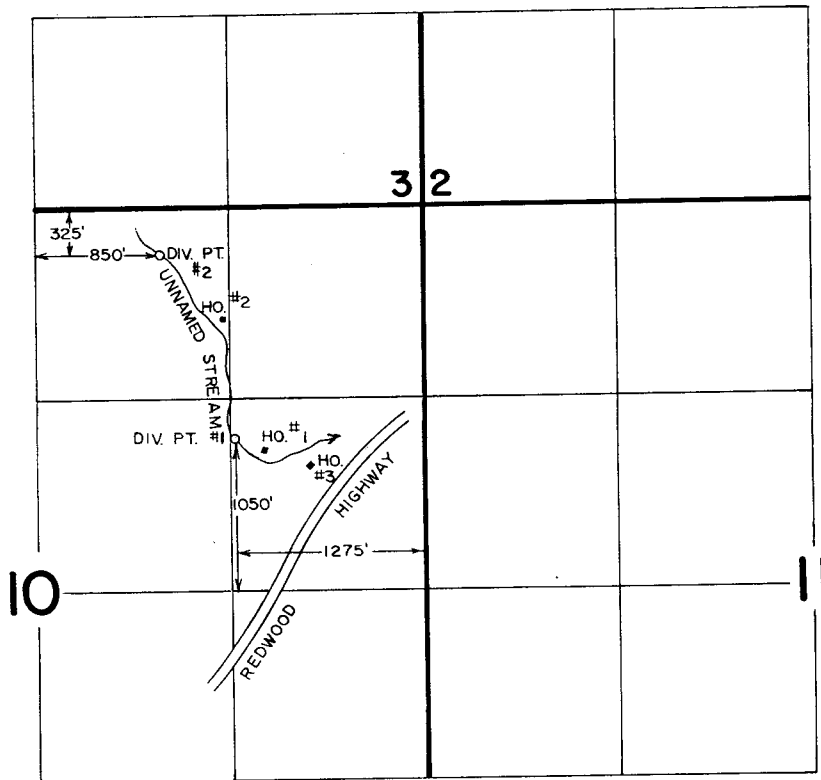

REMOVED

JUL 14 1988

WM. DIST. 14  
GRANTS PASS, OR.

**FINAL PROOF SURVEY**  
UNDER

Application No. 58316 Permit No. 44014  
IN NAME OF

GARY MORGAN & HARVEY MORGAN

Surveyed OCT. 24 1983, by B. S. JAMES

SCALE: 4" = 1 MILE

179-170L TWB