


T. 39 S., R. 5 W., W. M.

RECEIVED

JUL 3 1984

W.M. DIST. 1/4  
GRANTS PAGE ONE

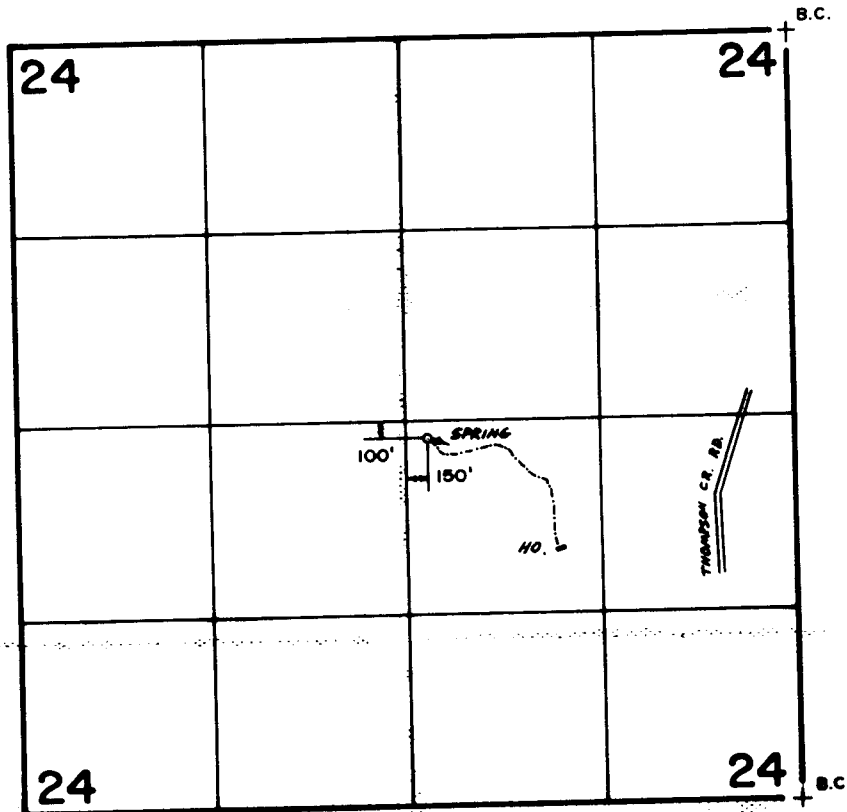

**FINAL PROOF SURVEY**  
UNDER

Application No. 58324. Permit No. 44015.....  
IN NAME OF

FLORENCE.....BROSS.....EATON.....

Surveyed May 13, 1982, by B.R. SUND.....

SCALE : 4" = 1 Mile

179-96R

bsi