

SECTION 31 T.5N. R.4W. W.M.

COLUMBIA COUNTY

APPROVED


This site has some flood plain along Rock Creek, house and septic system will need to be place accordingly

1" = 400'

Lawrence McDonald  
26 Feb 79

Minor Partition  
Steve Calhoun  
216 Louisiana Av  
Vernonia Ore  
Reciet # 7643  
Tax Account  
5431-000-0090

SEE MAP 5 4 30

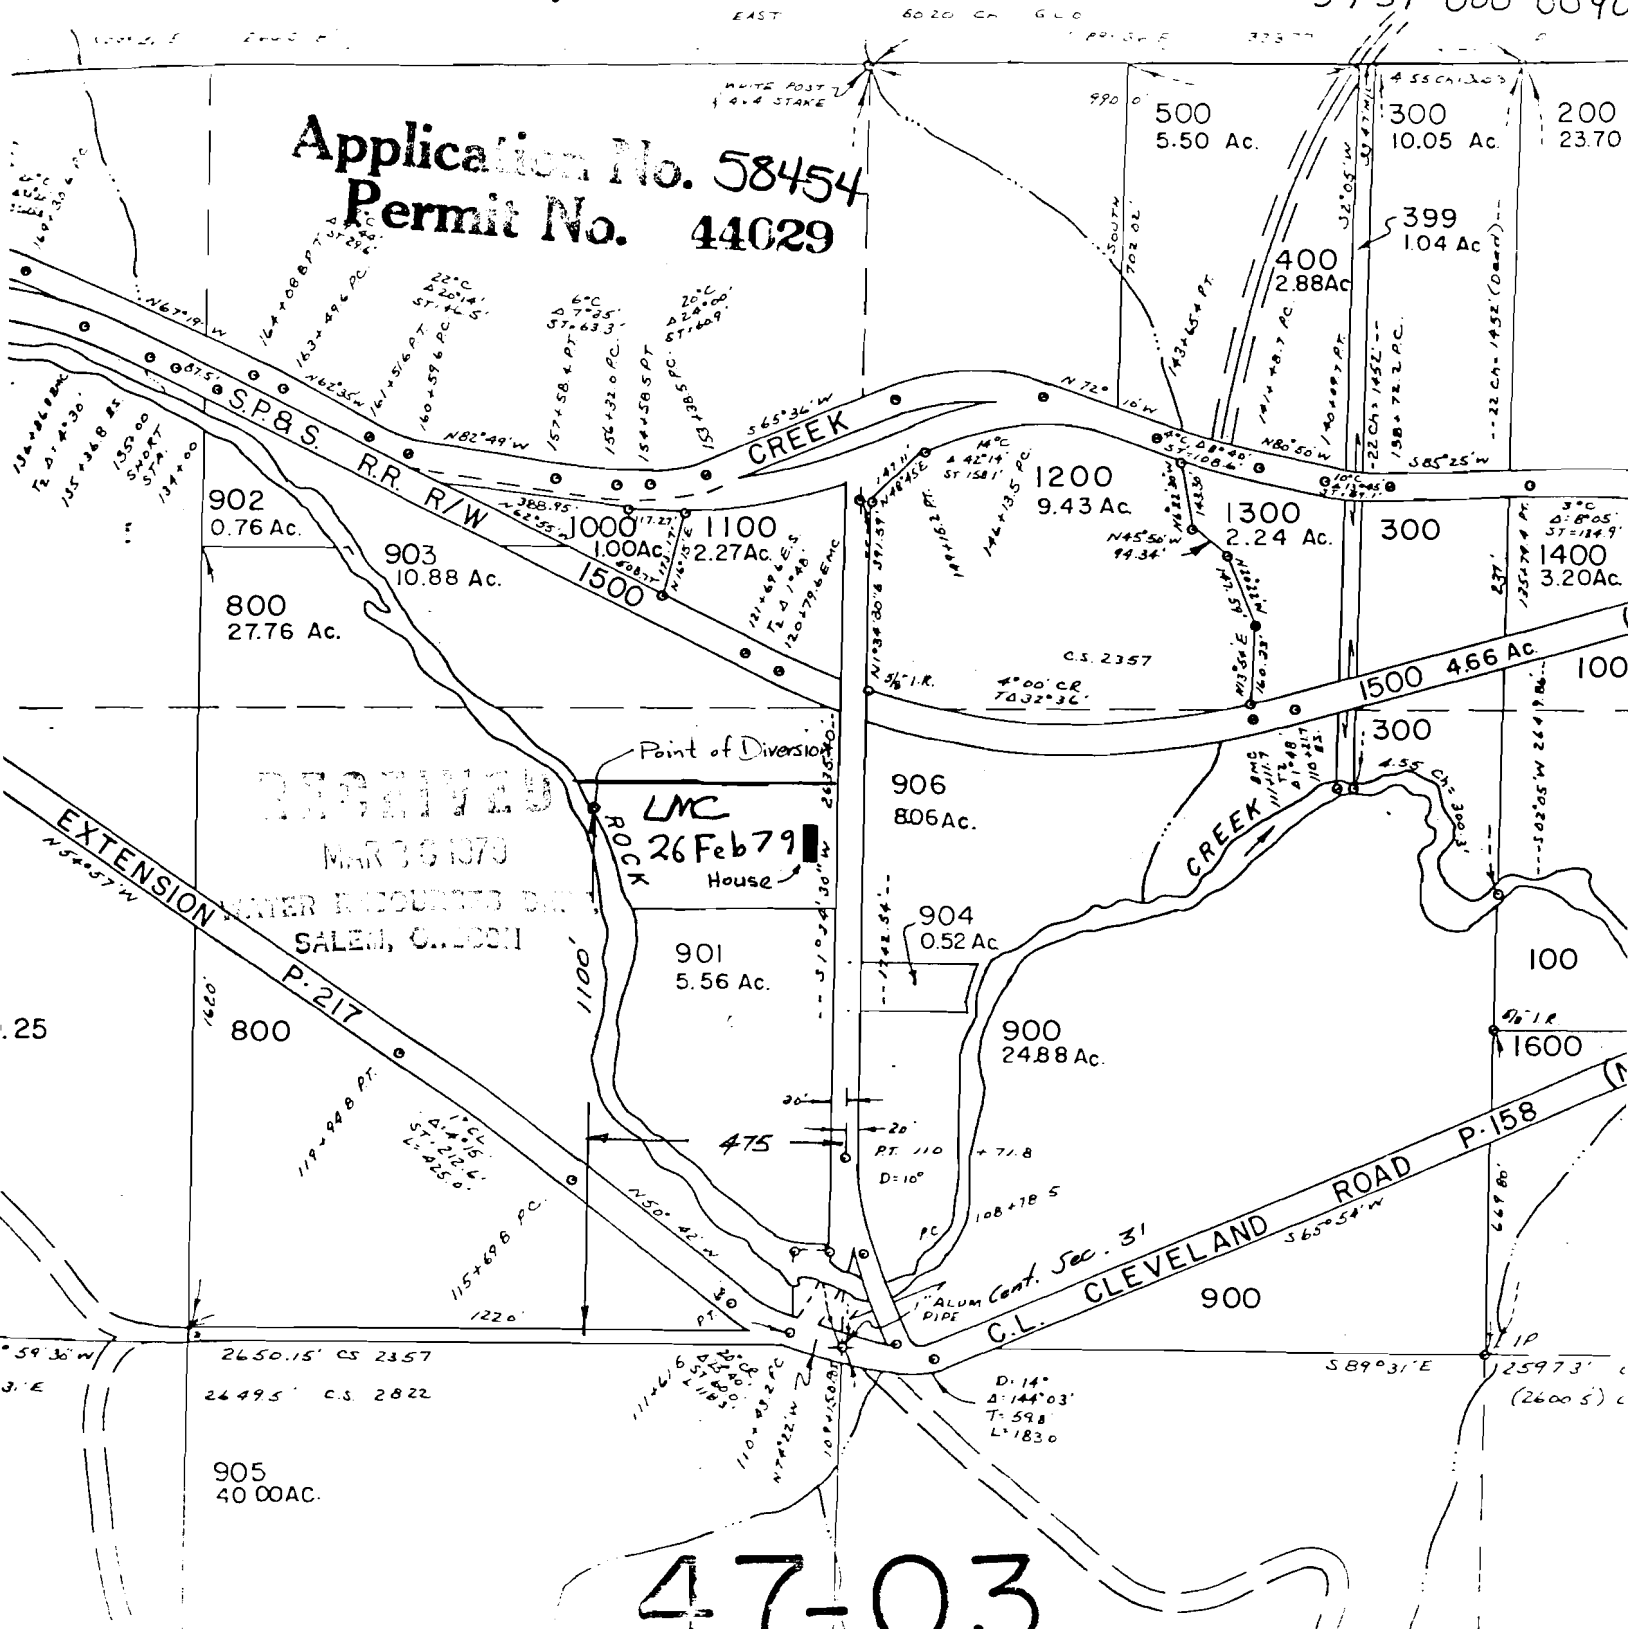

Application No. 58454  
Permit No. 44029

RECEIVED  
MAR 26 1979  
SALEM, OREGON

47-03