

RECEIVED

SEP 20 1972


STATE ENGINEER
SALEM OREGON

RECEIVED

MAR 14 1979

WATER RESOURCES DEPT.
SALEM, OREGON

Application No. **R-58400, 58401**
Permit No. **R 7813 44031**

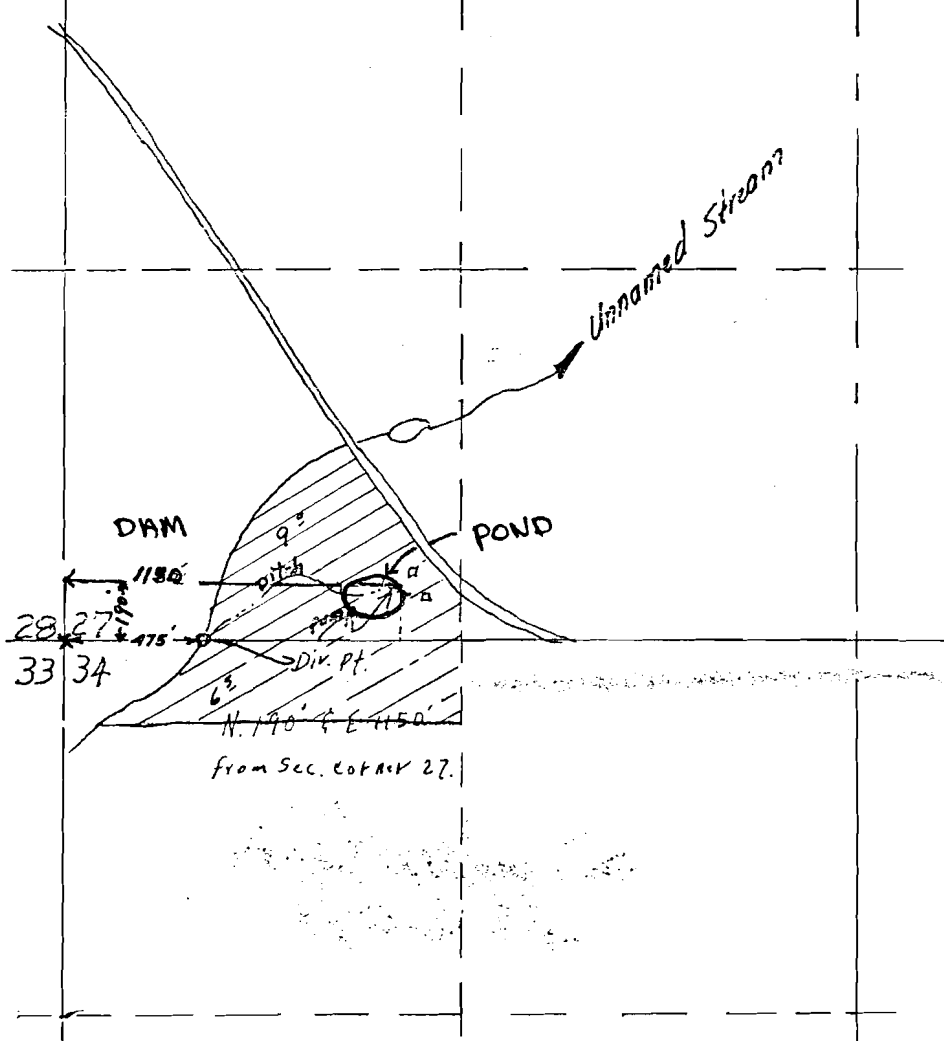

William Hurst

Sec. 27 T8S R.6W.

Scale 1" = 660'

Application No. **47737**
Permit No. **37246**