


# T. 37 S., R. 6 W., W.M.

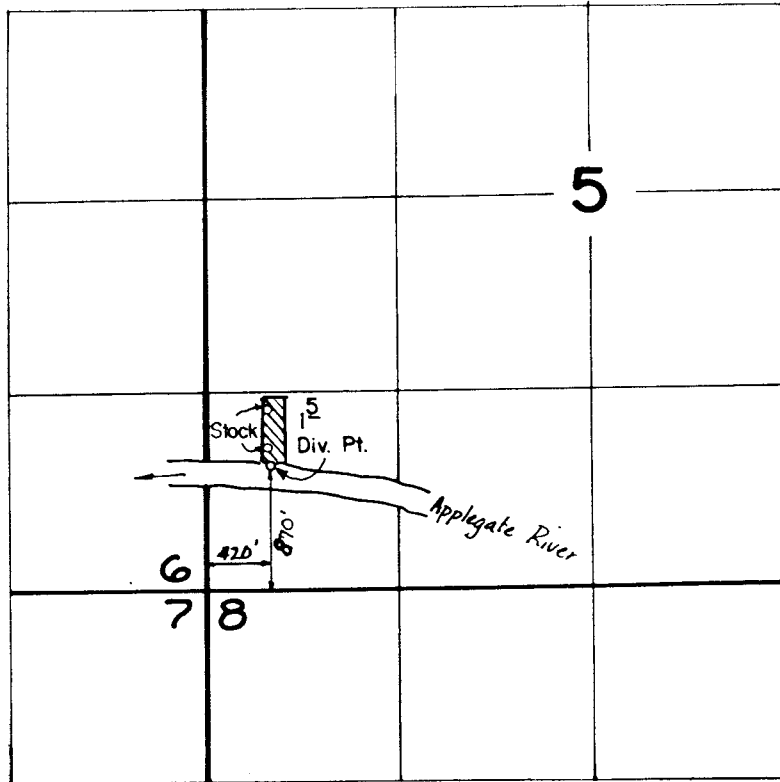

## FINAL PROOF SURVEY UNDER

RECORDED  
AUG 24 1989  
VAL. DIST. 14  
COUNTY CLERK, OR.

Application No. 58418... Permit No. 44052...  
IN NAME OF  
JOSEPH J. ORRIO  
Surveyed OCT. 18, 1983, by B. S. JAMES

B50-3-11 mc 2/89