Sec 22 T. 36 S.

6S. R. 7 W. W. M.

COUNTY

36 7 2

Application No. 58450
Permit No. 44062

6 7 15
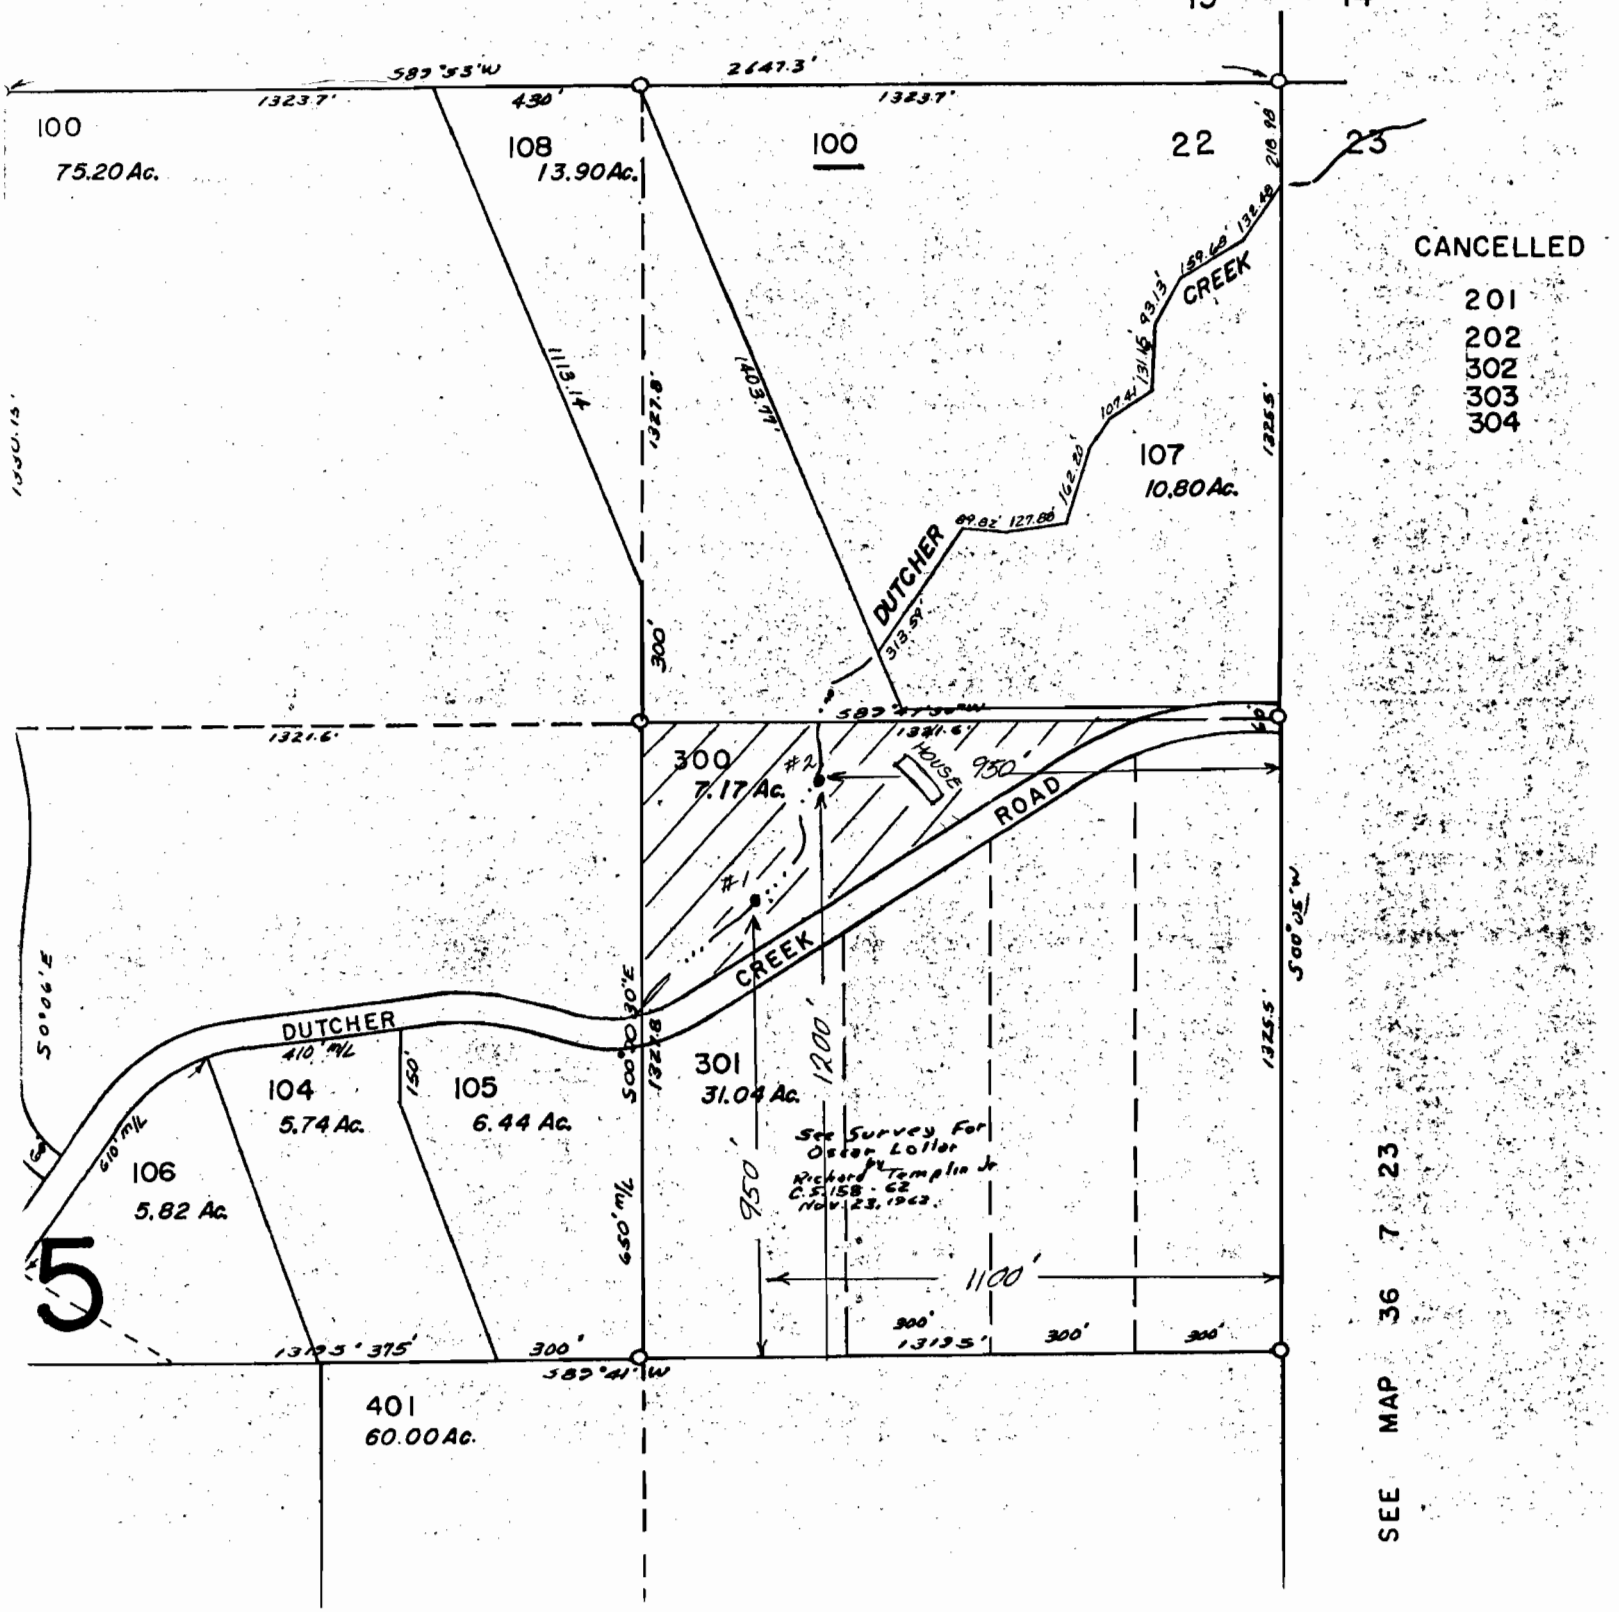
15 14