


TWP. 33S. R4W

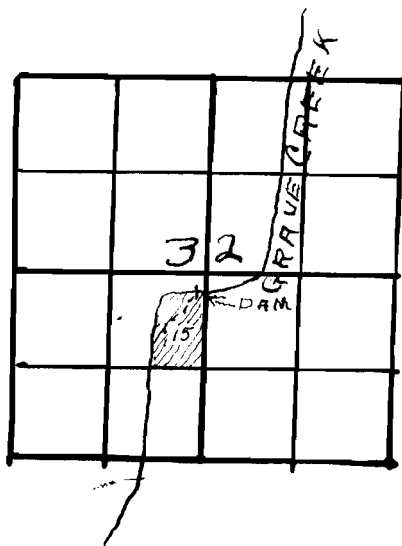

**Application No.**

7040

**Permit No.**

4409