

WATER RIGHTS SURVEY

FOR


C. L. (CLINT) PAINTER

GOV LOTS 3 & 4, N 1/2 of LOTS 5, 6 & 7, SEC. 5
AND GOV LOT 1, SEC 6, T4N, R8W, W.M.
SCALE 1"=600' JANUARY 1979

NOTE: THIS SURVEY BASED ON O.S.B.F.
1971 SURVEY RECORDED AS SURVEY
NO. 5253, C.C.S.R. AND AERIAL
PHOTO INTERPRETATION FROM
1977 PHOTO'S.

Application No. 58339
Permit No. 44135

RECEIVED
FEB 20 1979
WATER RESOURCES DEPT.
SALFORD, OREGON

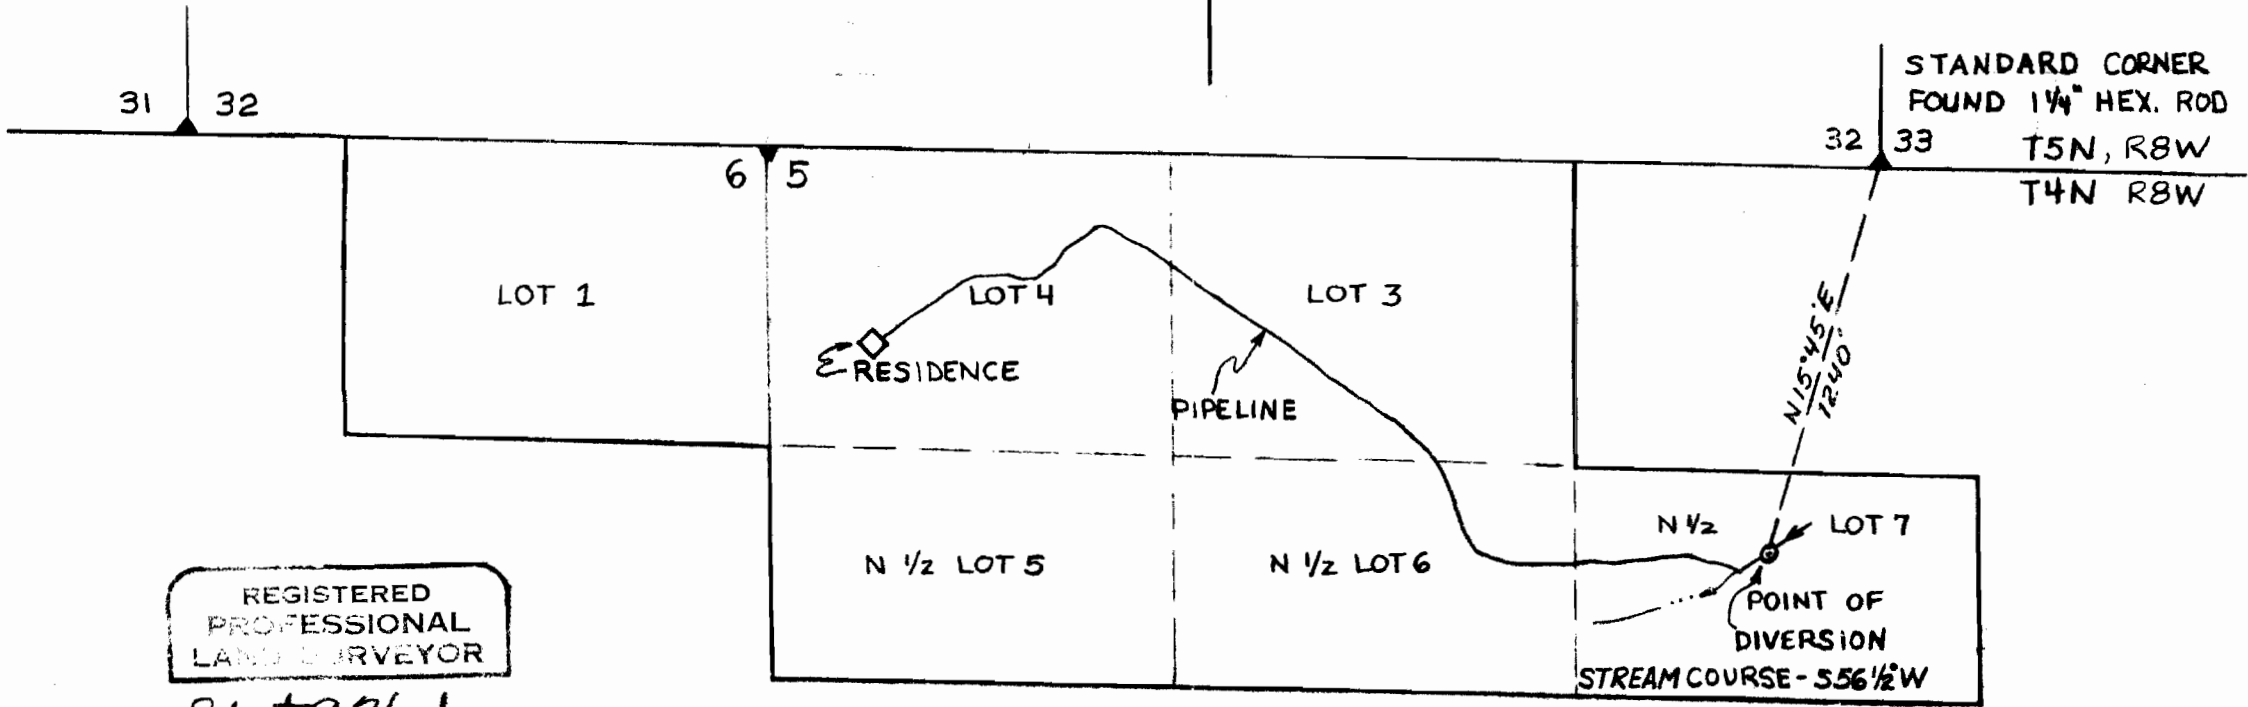

REGISTERED
PROFESSIONAL
LAND SURVEYOR

Robert A. Hovden

OREGON
JULY 16, 1971
ROBERT A. HOVDEN
954

RECORDED
MAY 04 1979
WATER RESOURCES DEPT.
SALFORD, OREGON