


RECEIVED

APR 09 1979

WATER RESOURCES DEPT.
SALEM, OREGON

1-08

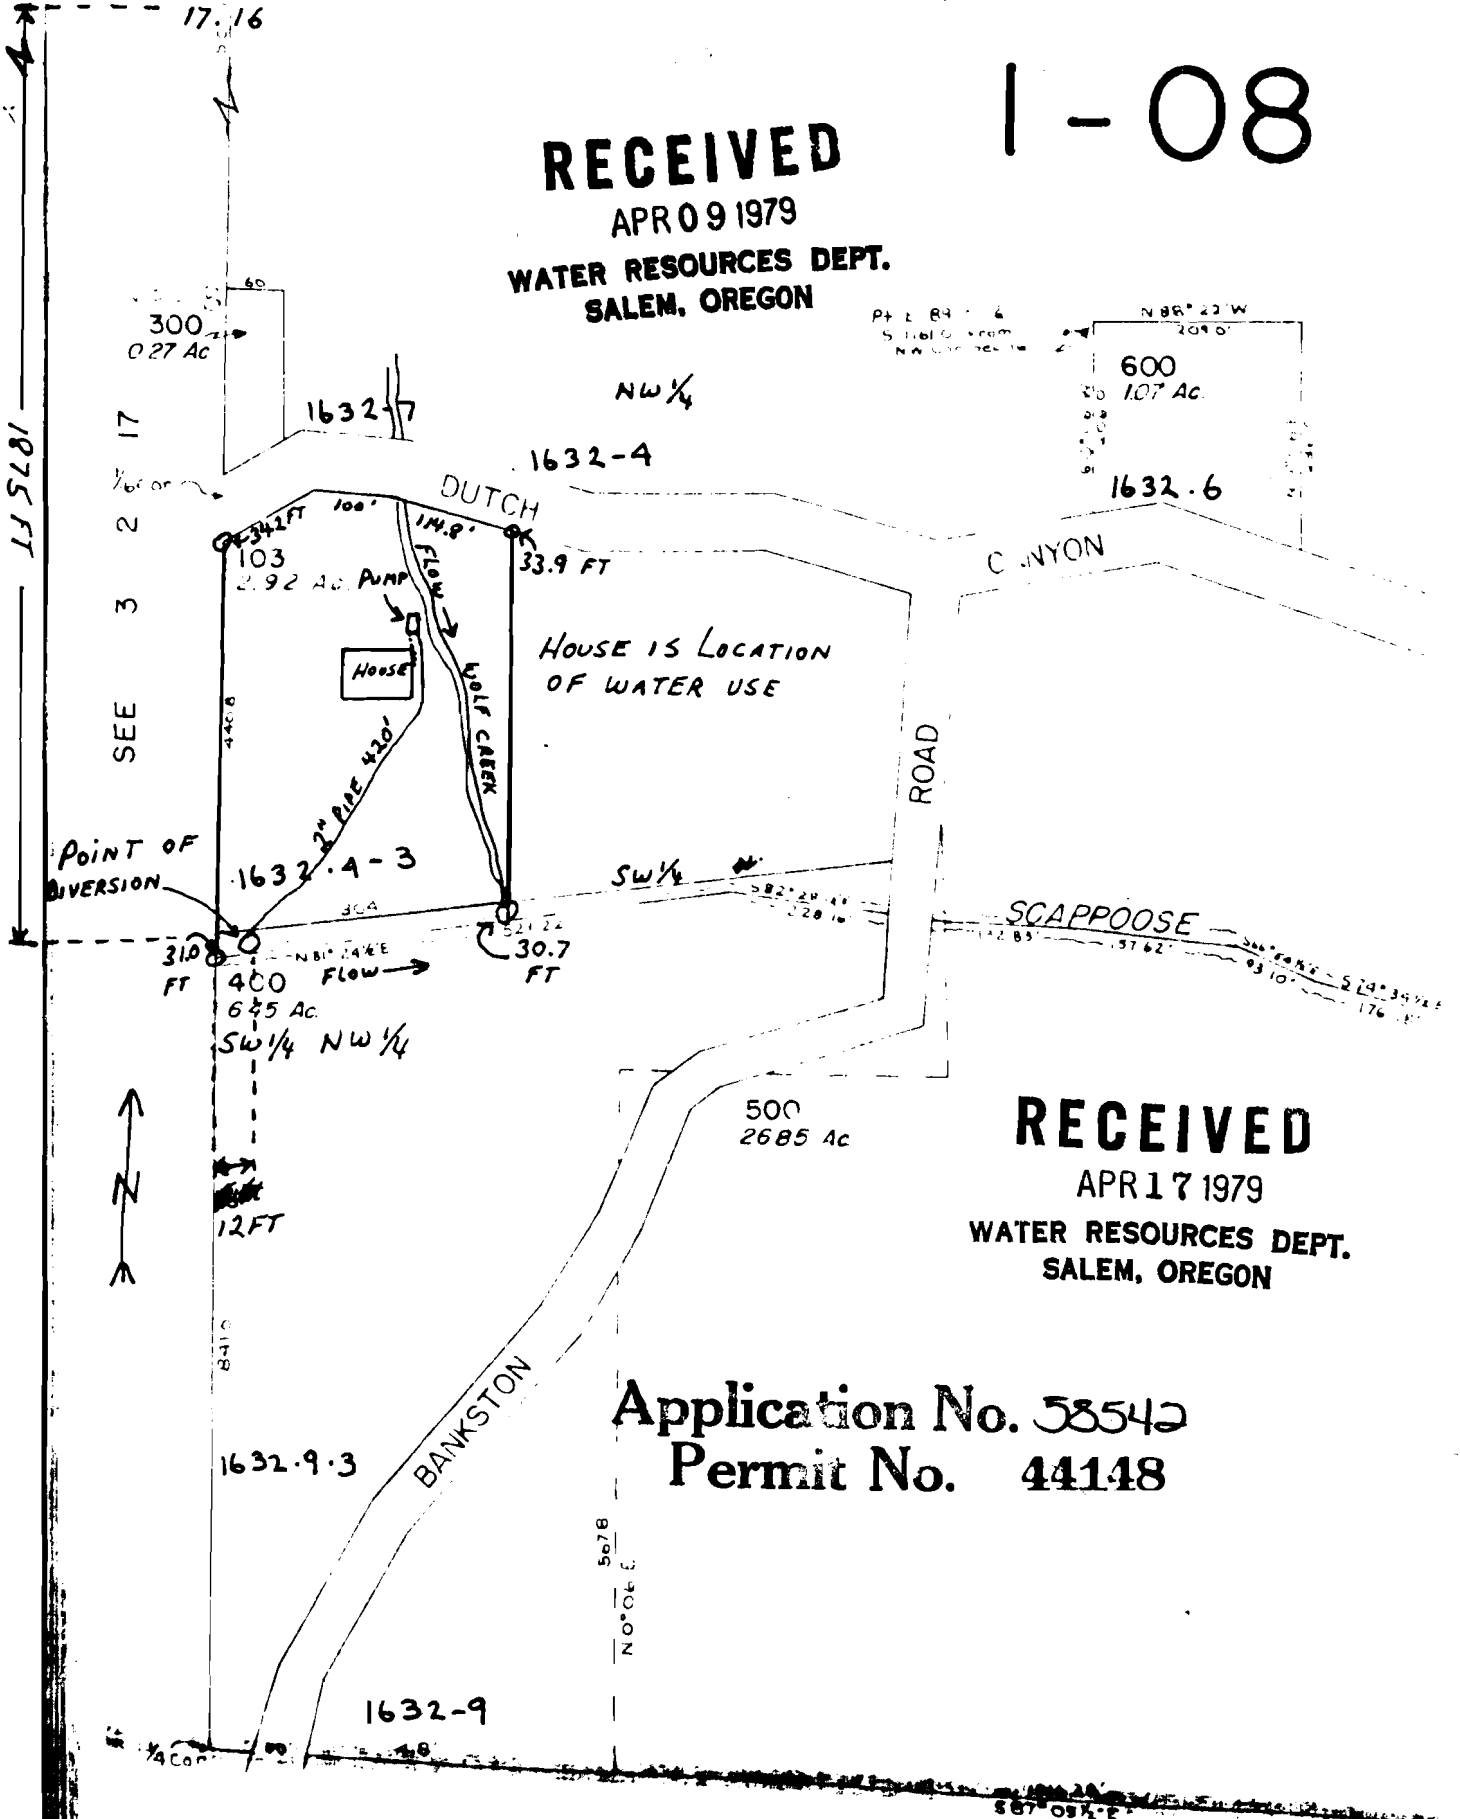

RECEIVED

APR 17 1979

WATER RESOURCES DEPT.
SALEM, OREGON

Application No. 58542
Permit No. 44148

TAKEN FROM COUNTY MAP
OTTO KOMNING PROPERTY
SEC 16 TWP 3N RANGE 2W
COLUMBIA COUNTY OREGON

SEE 3 2 16

SCALE 1" = 200 FT