

COLUMBIA RIVER

T. 4N., R. 25E., W. M.

35 F.C.

Div. Pt. C.I.D.

Main Pump C.I.D.

DIRT ROAD

T. 5N.

T. 4N.


2

NW 1/4 NE 1/4

NE 1/4 NE 1/4

Scale 1" = 400'

T. 2N., R. 26E., W. M.

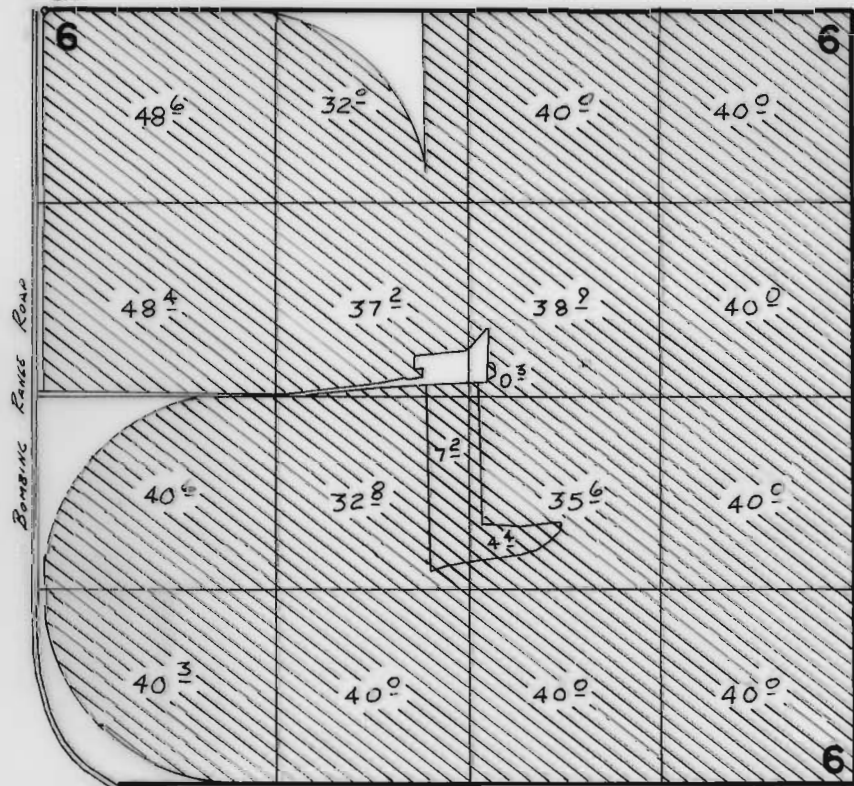

Div. Pt. C.I.D. Loc: 150' S. and
2995' W. From NE Cor.
Sec. 2

FINAL PROOF SURVEY

UNDER

Application No. **58329** Permit No. **44153**.....

IN NAME OF

JERALD E. REA

Surveyed 11-15 1983, by R. G. Church.....