


T.2N R30E. W.M.

Application No. 58563
Permit No. 44220

RECEIVED
JUN 04 1979
WATER RESOURCES DEPT.
SALEM, OREGON

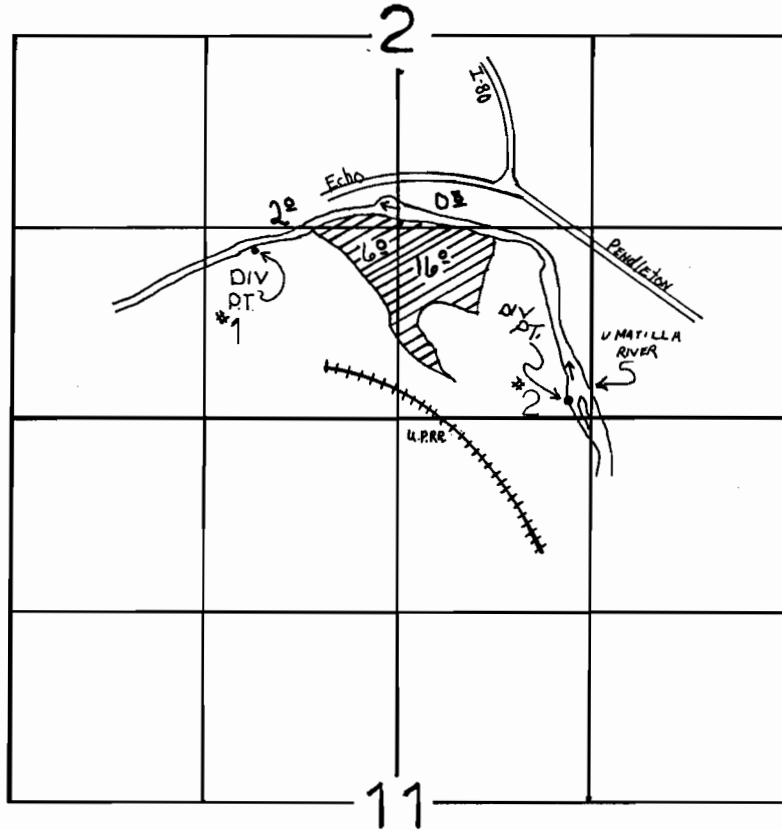

DIV PT *2 150' N. & 1450' W FROM SE COR SEC 2
DIV PT *1 1150' N. & 1650' E FROM SW COR SEC 2

RECEIVED
APR 20 1979
WATER RESOURCES DEPT.
SALEM, OREGON