


T.37S., R.6W., W.M.

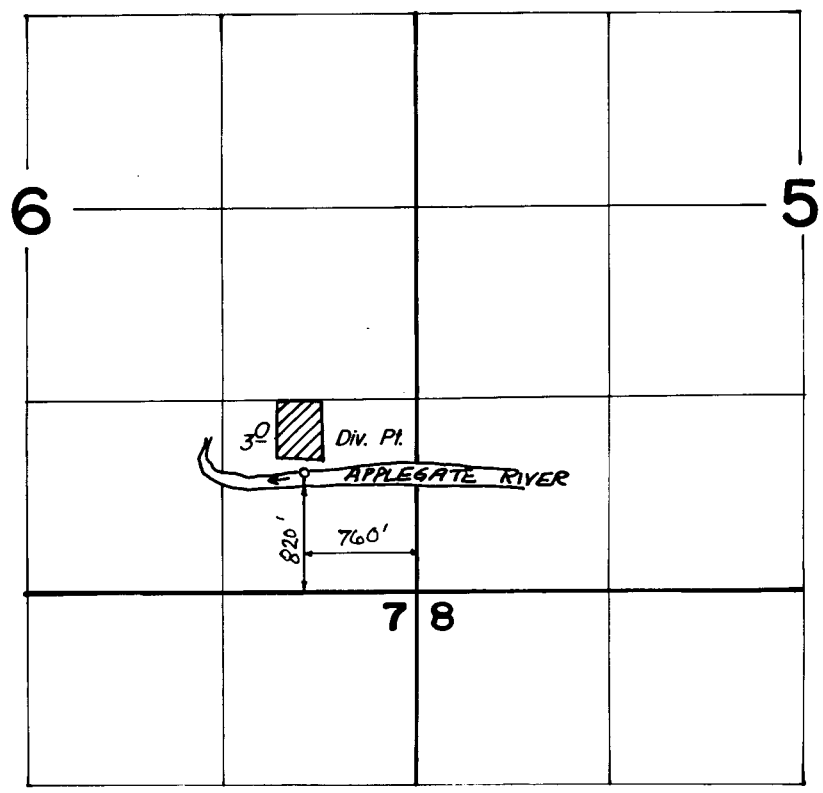

RECEIVED

APR 1 1987

WM DIST 14
GRANITE PASS, ORG.

FINAL PROOF SURVEY
UNDER

Application No. 58708 Permit No. 44282....
IN NAME OF

.....**DAVID C. RAVENCROFT**.....

Surveyed Aug. 10, 1982., by B.S. JAMES.....

850-3-11 me 2/84