
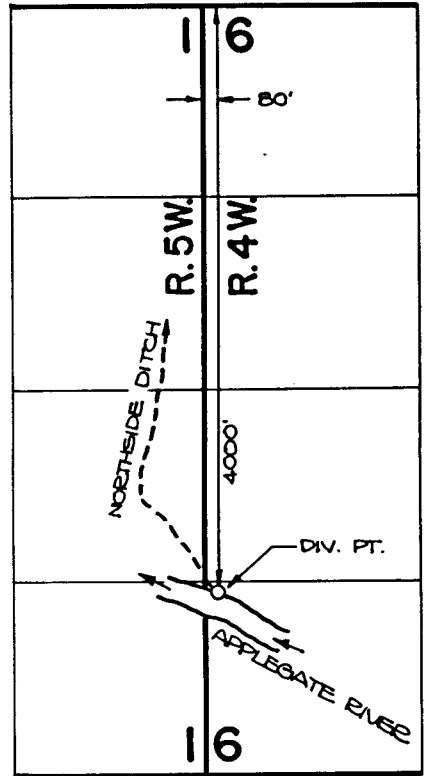


T. 37S., R. 5W., W. M.

T. 38S., R. 4 & 5W., W.M.

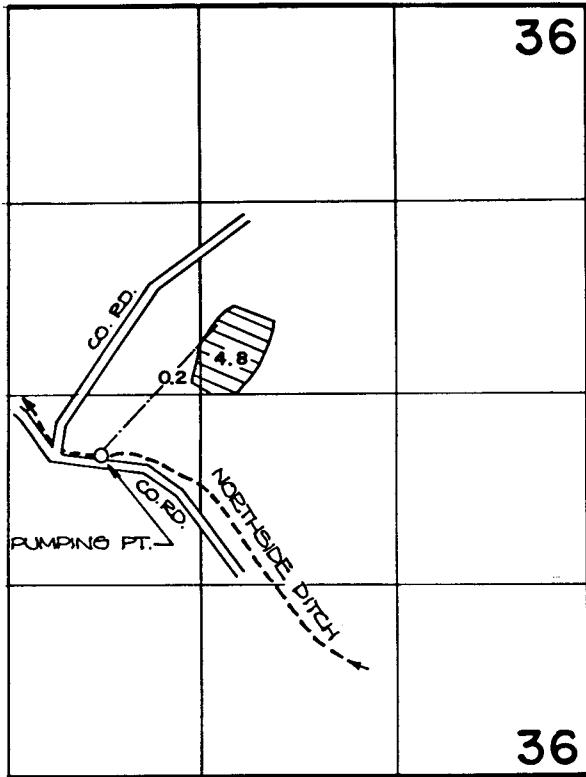

FINAL PROOF SURVEY
UNDER

Application No. **61894** **58813** Permit No. **45884** **44328**
IN NAME OF

.....**R. B. HODGE**.....

Surveyed **AUG. 18. 19.83**, by ..**B. JAMES**.....

RECEIVED

DEC 17 1986

VM. DIST. 14
GRANTS PASS, ORE.