



T. 40 S., R. 9 W., W. M.

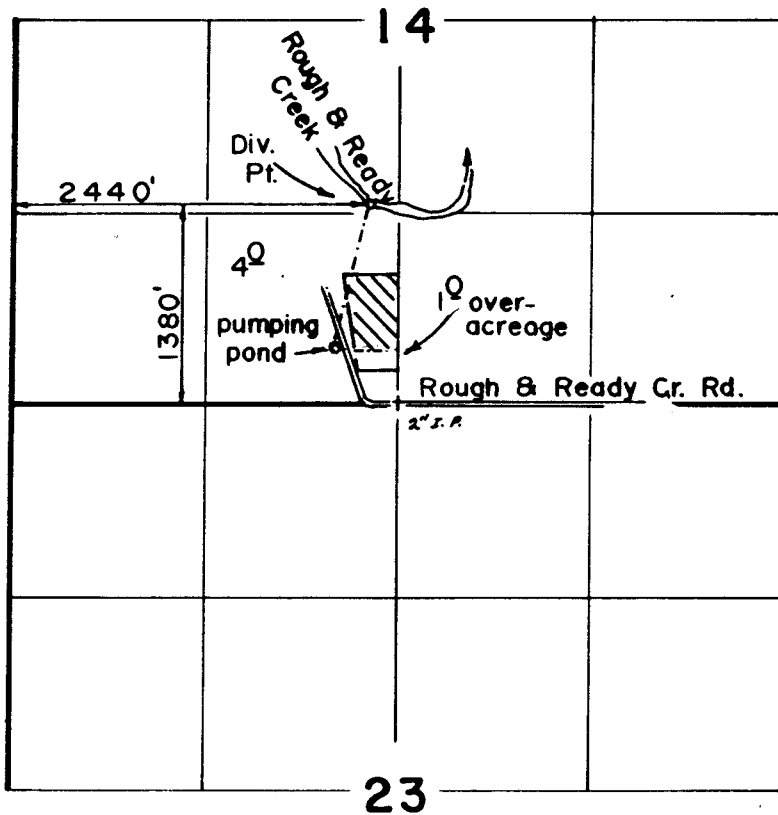

Scale: 1" = 1320'

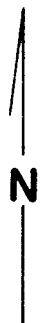

RECORDED

JUL 11 1989

REG. DIST. 14
COUNTY PAGE 100

FINAL PROOF SURVEY
UNDER

Application No. **58768**. Permit No. **44332**.
IN NAME OF

.....**ERROS W FEEHELY**.....

Surveyed APR. 10. 1986, by B. S. JAMES.