

R59583

Application No. 51584

Permit No. 44335

R 7845


T 225

R 5 W W M

RECEIVED

JUN 28 1978

WATER RESOURCES DEPT.  
SALEM, OREGON

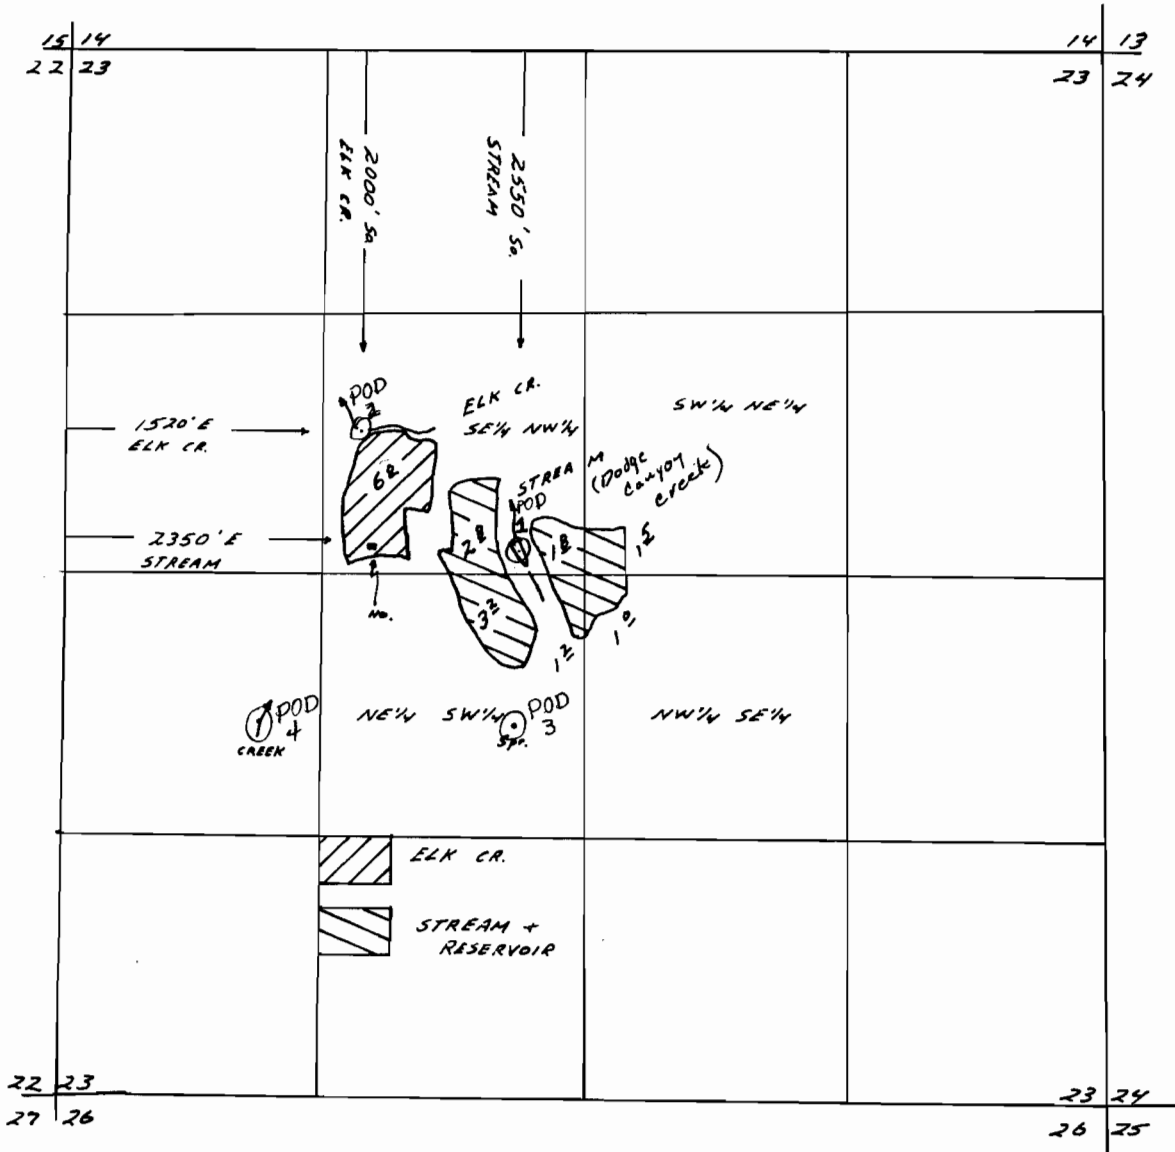

SPRING: 3520' S, 2350' E within NE 1/4 SW 1/4 primary dam  
 CREEK: 3520' S, 1000' E within NW 1/4 SW 1/4 Suppl. dam  
 both from the NW cor. Sec. 23