


T. 27S. R. 6W. S. 15

RECEIVED

JUN 27 1979

WATER RESOURCES DEPT
SALEM, OREGON

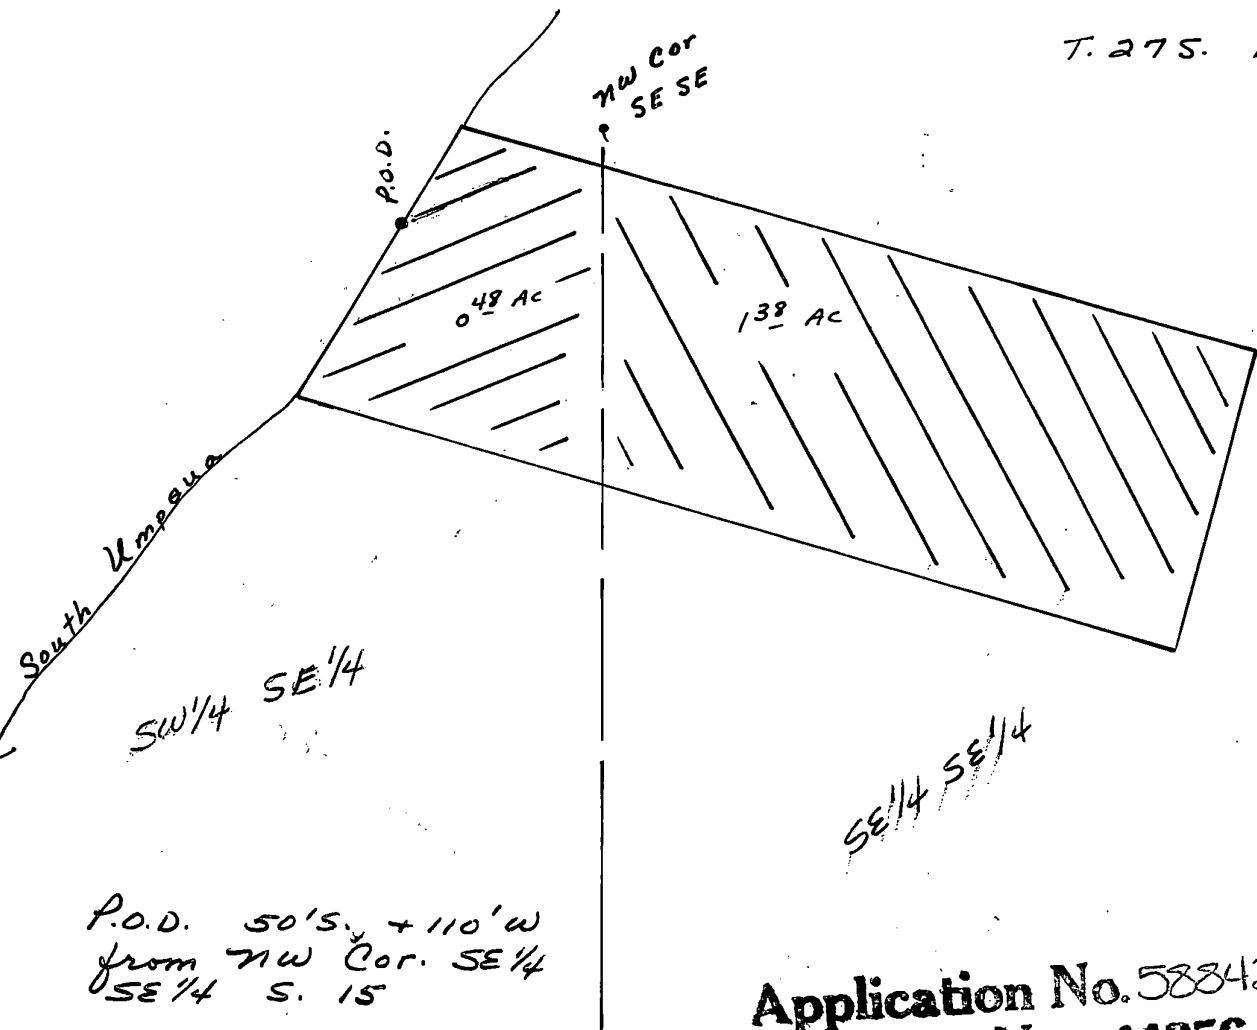

P.O.D. 50'S. + 110'W
from NW Cor. SE 1/4
SE 1/4 S. 15

Application No. 58842
Permit No. 44356