


T. 37 S., R. 6 W., W.M.

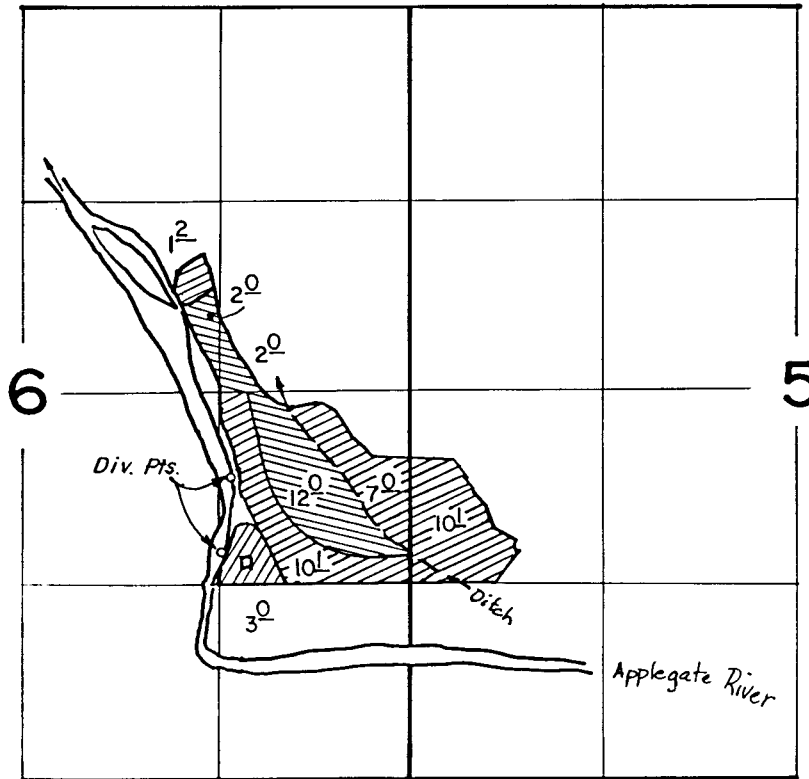


N'LY Div. Pt. located 2060' N. & 1220' W.  
 S'LY Div. Pt. located 1550' N. & 1300' W.  
 Both from S.E. Corner Section 6.

RECORDED

MAR 20 1987

REG. DIST. 14  
 GRANTS PASS, ORE.

**FINAL PROOF SURVEY**  
 UNDER

	62127	47296	
TRANSFER NO.	4249		
Application No.	58883	44434	
Permit No.	44429		

IN NAME OF

**SUZANNE K. POETT**

Surveyed AUG. 11, 1982, by B. S. JAMES  
 " MAY 5, 1983 " " "

B50-3-11

mc 2/84