


T. 35 S., R. 7 W., W. M.

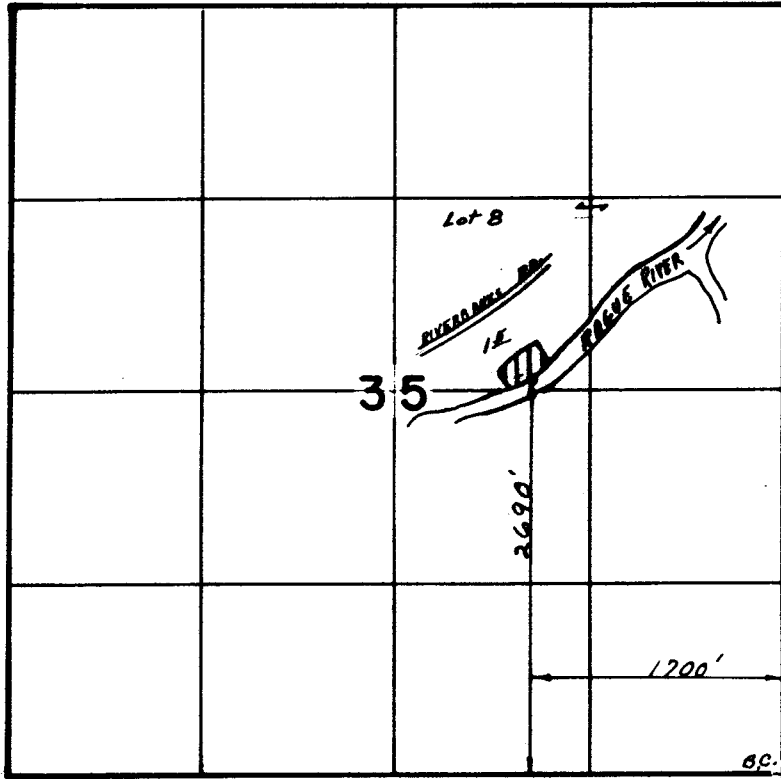

NOV 23 1989

Scale: 1" = 1320'

FINAL PROOF SURVEY
UNDER

Application No. 59227 Permit No. 44483
IN NAME OF

JOHN W. MC LOUGHLIN

Surveyed NOV. 3, 1987, by B. S. JAMES

41033-179-166R LMS