


RECEIVED

5-17-37

DEPT. OF THE INTERIOR
BUREAU OF LAND MANAGEMENT

Section 22, T. 27S. R. 4W.

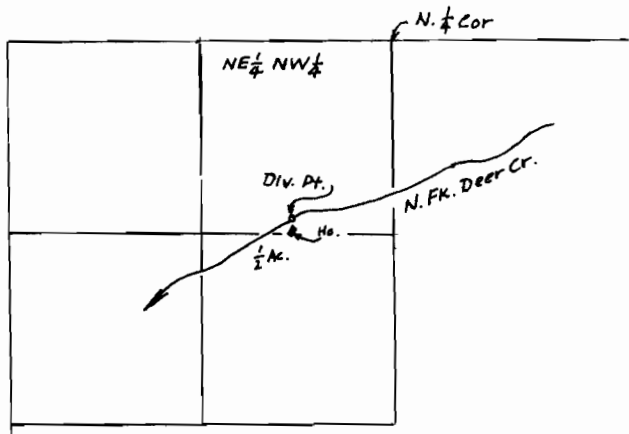

Application No. 592641
Permit No. 4495

Scale: 4" = 1 mile

Div. Pt: 1220' S. and 700' W
from N 1/4 cor. Sec. 22