

RECEIVED

AUG 10 1979

WATER RESOURCES DEPT
SALEM, OREGON

RECEIVED

JUL - 8 1979

WATER RESOURCES DEPT
SALEM, OREGON

SEC. 26 T. 1 S., R. 9 W. WM.

TILLAMOOK, OREGON

JUNE 23, 1979

SCALE 1"=100'


RECEIVED

OCT 17 1979

WATER RESOURCES DEPT
SALEM, OREGON

Application No. 58303

Permit No. 44502

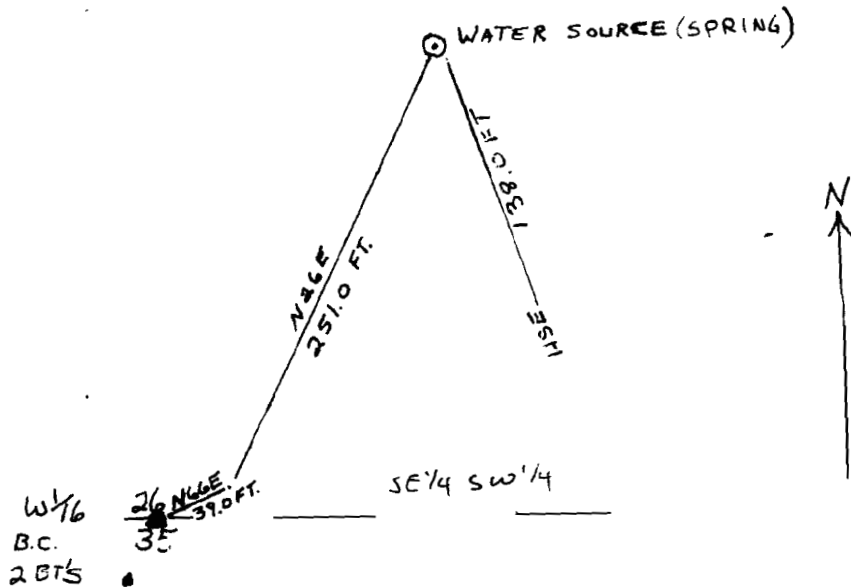

SURVEYED BY
J. W. ...
FOREST ...
6-23-79