

RECEIVED

MAY 31 1979

WATER RESOURCES DEPT.
SALEM, OREGON

T. 6 S., R. 3 W., W.M.


RECEIVED

Application No. 58731


R 58730 NOV 11 1979
WATER RESOURCES DEPT
SALEM, OREGON


Permit No. R 7956

44518

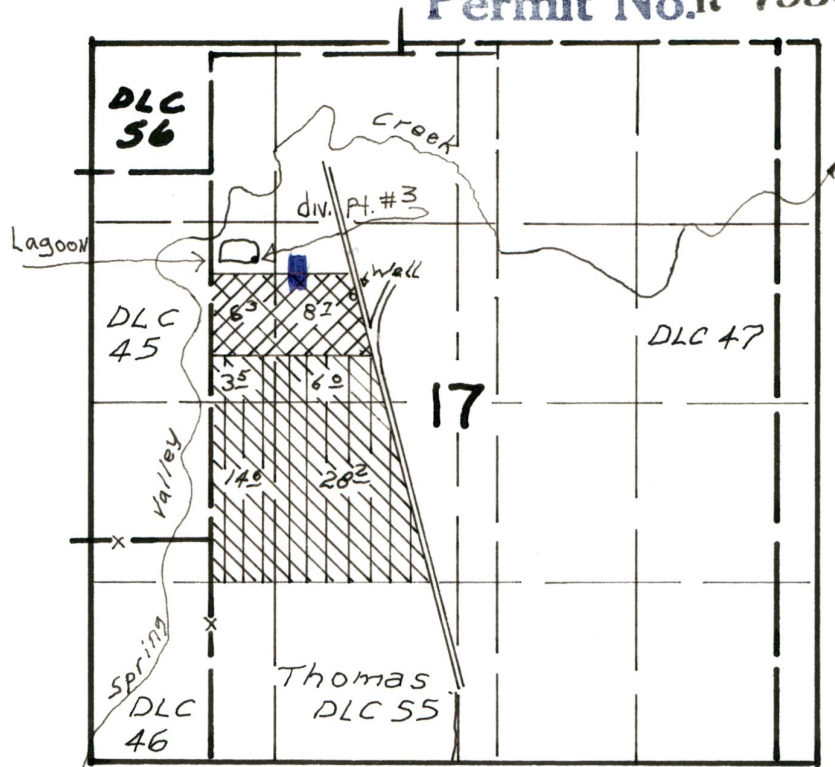

Well Loc.: 1860' S., & 1880' E. from NW cor. Sec. 17
Div Pt. #3 Loc. 1560' S & 1188' E. from NW cor. Sec. 17

 Supp'L to surface permit

 Supp'L to well permit

 BAW

Sidney Van Dyke