


# T. 35 S., R. 7 W., W.M.

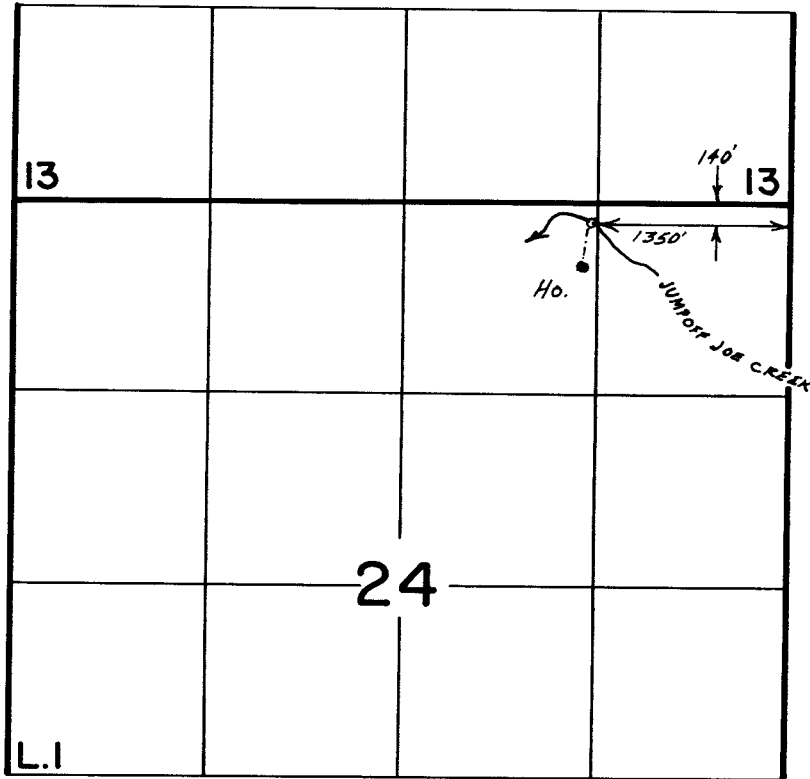

Scale 1" = 1320'



## FINAL PROOF SURVEY UNDER

RECEIVED

JUL 18 1991

WM. DIST. 14  
GRANTS PASS, ORE.

Application No. 58967.. Permit No. 44574.....  
IN NAME OF

.....JACK.....R.....GIBSON.....

Surveyed Oct. 28, 1987, by B.S.JAMES.....