


44576
36-5-20

T.36 S., R.5 W., W.M.

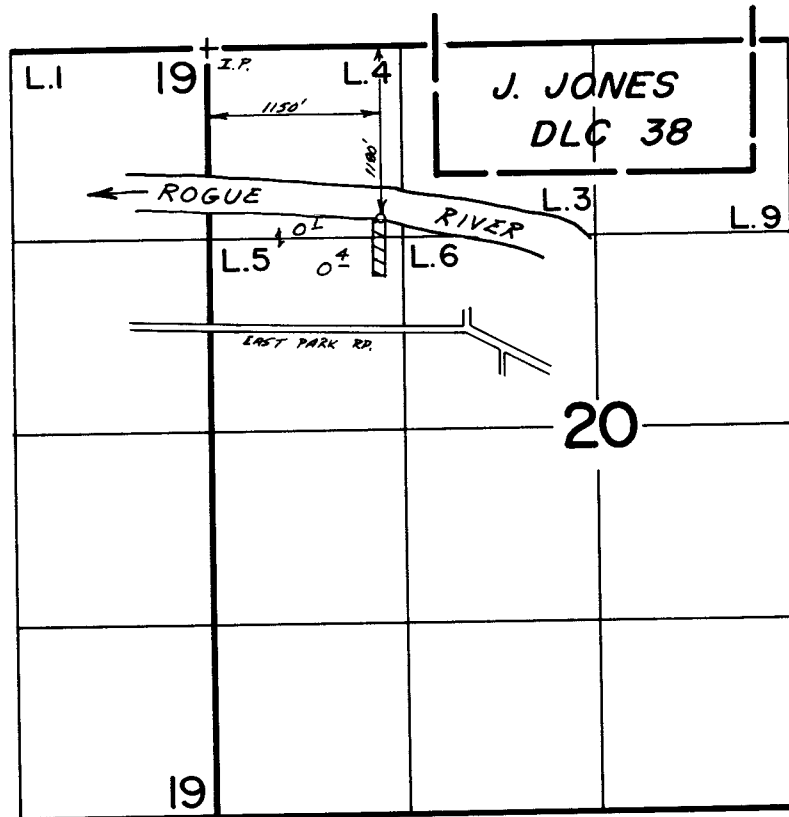

Scale 1"=1320'

FINAL PROOF SURVEY
UNDER

Application No. 58984 Permit No. 44576
IN NAME OF

WILLIAM E. LEWIS

Surveyed Oct. 15, 1986, by B.S. JAMES

RECEIVED

JUL 31 1992

WM. DIST. 14
GRANTS PASS, ORE.

BSO-5-9

bsj