Application No. 59358
Permit No. 44615

T.1N. R.27E. W.M.

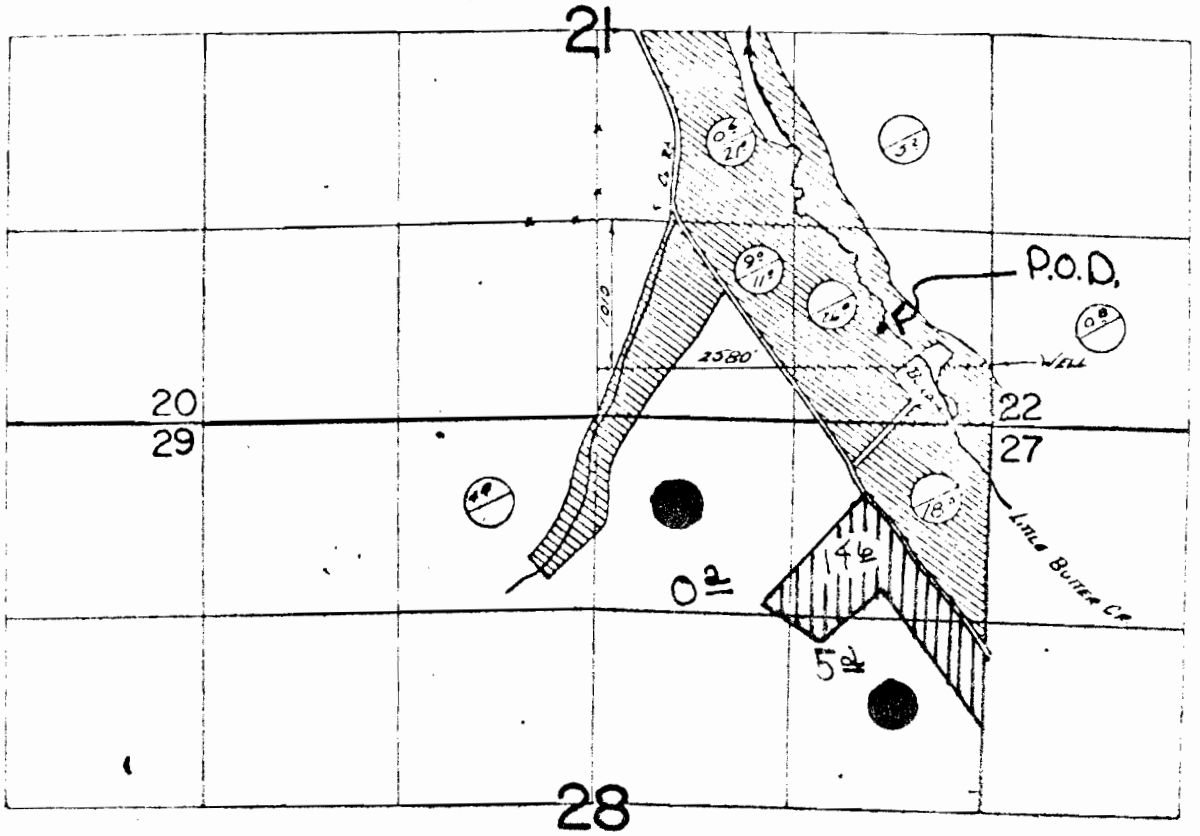

P.O.P. Location

700' N. + 750' W. from the S.E. Corner of Sec. 21

Butter Creek

F DM for USGS map

172-175