


T. 36 S., R. 7 W., W. M.

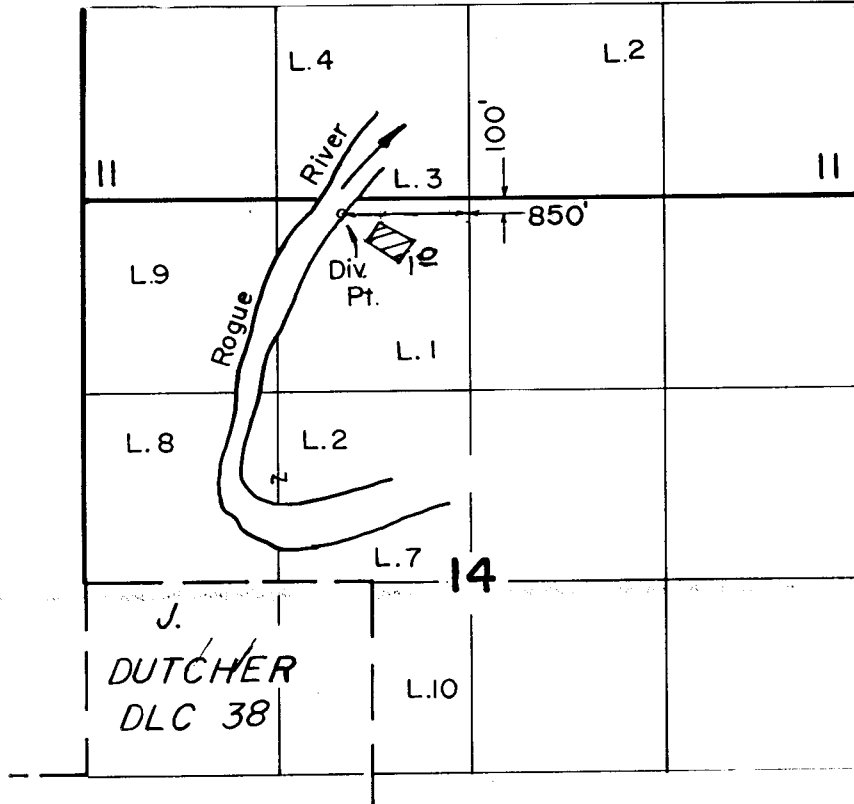

Scale: 1" = 1320'

**FINAL PROOF SURVEY**  
UNDER

Application No. 59335 Permit No. 44630  
IN NAME OF

.....  
Surveyed OCT. 6 1987, by B. S. JAMES..

RECEIVED

SEP 4 1990

WM. DIST. 14  
GRANTS PASS, ORE.

B.50-6-16 LMS