


T. 33S. R. 6W. W.M.

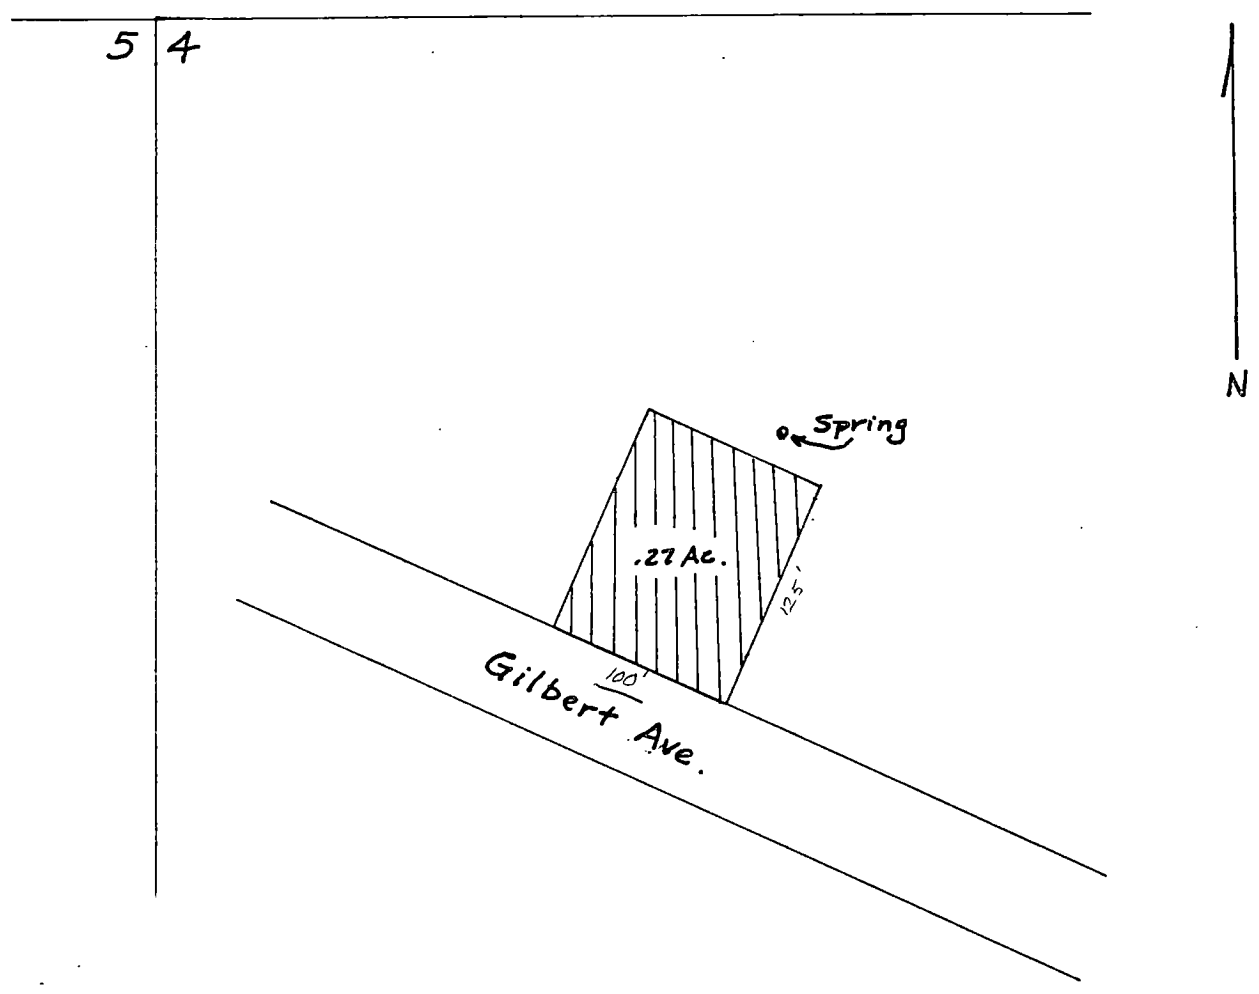

Scale: 1" = 100 ft.

Spring located 215'S. and 325'E from NW cor. Sec. 4  
Land to be irrigated is lots 7 & 8 of Gilbertson's Addition

Application No. 59328  
Permit No. 44643