


T. 34 S., R. 5 W., W.M.

Sec. 24

NW 1/4 SE 1/4

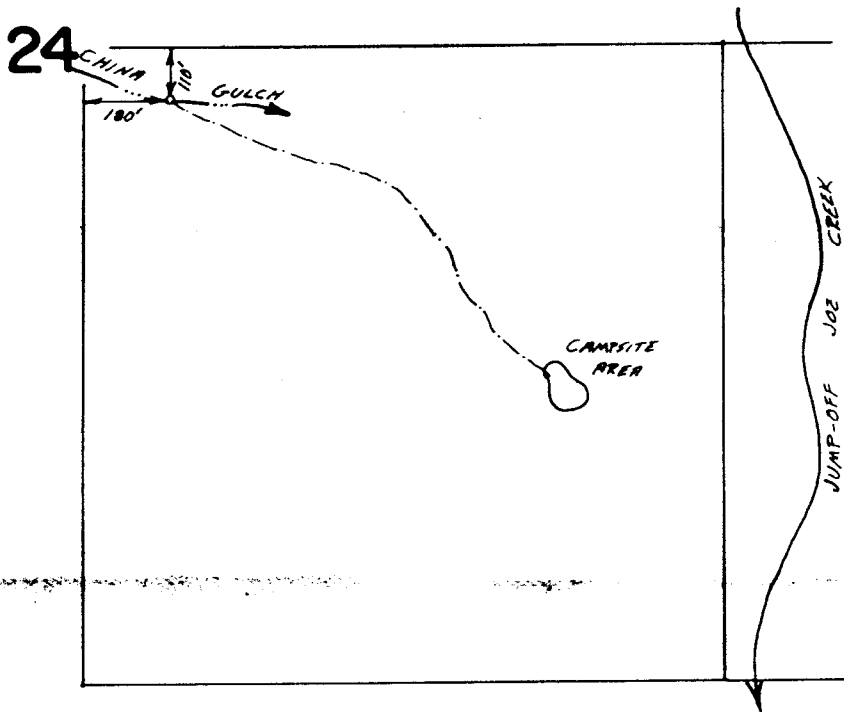

Scale 1" = 400'

RECEIVED

DEC 21 1988

W.M. DIST. 14  
QUARTS. P. 3, ONE

**FINAL PROOF SURVEY**  
UNDER

Application No. 59469 Permit No. 44692  
IN NAME OF

GARFIELD Wm. PRIEBS

Surveyed Aug. 12. 1986, by B.S. JAMES

No. 12-76-51 & WIMBER OREG. QUAD bji